




LOCATION OF THE
SILER BROS. COAL CO.
GASTONVILLE MINE

Mapped, edited, and published by the Geological Survey
Control by USGS, USC&GS, and City of Pittsburgh
Topography from aerial photographs by photogrammetric methods
Aerial photographs taken 1952. Revised by photogrammetric methods
from aerial photographs taken 1959. Field check 1960
Polyconic projection. 1927 North American datum
10,000-foot grid based on Pennsylvania coordinate system, south zone
1000-meter Universal Transverse Mercator grid ticks,
zone 17, shown in blue
Fine red dashed lines indicate selected fence and field lines where
generally visible on aerial photographs. This information is unchecked
Red tint indicates areas in which only landmark buildings are shown

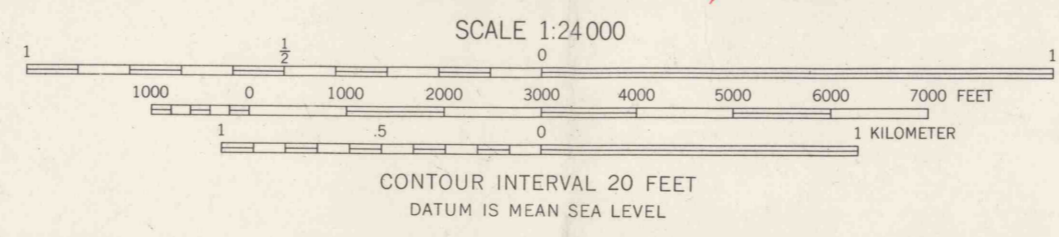


FIELD COPY

THIS MAP COMPLIES WITH NATIONAL MAP ACCURACY STANDARDS
FOR SALE BY U.S. GEOLOGICAL SURVEY, WASHINGTON 25, D. C.
A FOLDER DESCRIBING TOPOGRAPHIC MAPS AND SYMBOLS IS AVAILABLE ON REQUEST

ENGELHARDT - POWER & ASSOC., INC.
REG. ENGRS. CANONSBURG, PA.

ROAD CLASSIFICATION
Heavy-duty ——— Light-duty ———
Medium-duty ——— Unimproved dirt ———
State Route ○

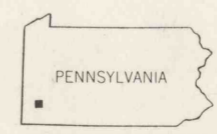

GLASSPORT, PA.
SW/4 PITTSBURGH 15' QUADRANGLE
N4015-W7952.5/7.5

1960