



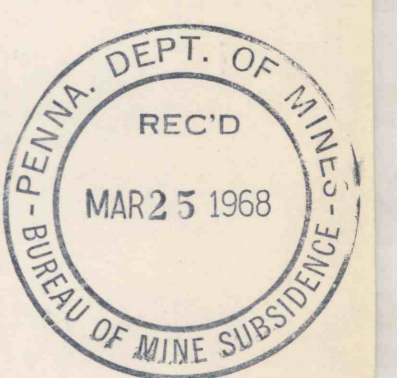


CHANNEL COAL INC
SHERO MINE
March 15, 1968



FIELD COPY

Mapped, edited, and published by the Geological Survey
Control by USGS and USCGS
Topography by photogrammetric methods from aerial
photographs taken 1958. Field checked 1961.
Polyconic projection. 1927 North American datum.
10,000-foot grids based on Pennsylvania coordinate system,
south and north zones.
1000 meter Universal Transverse Mercator grid ticks,
zone 17, shown in blue.
Red tint indicates areas in which only landmark buildings are shown.
Fine red dashed lines indicate selected fence and field lines where
generally visible on aerial photographs. This information is unchecked.

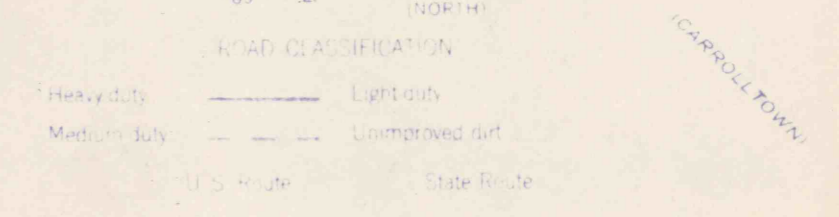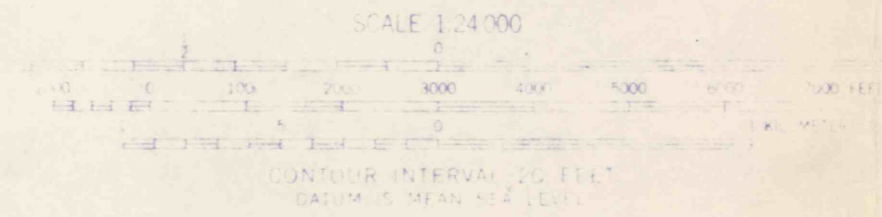

THIS MAP COMPLEES WITH NATIONAL MAP ACCURACY STANDARDS
FOR SALE BY U. S. GEOLOGICAL SURVEY, WASHINGTON 25, D. C.
A FOLDER DESCRIBING TOPOGRAPHIC MAPS AND SYMBOLS IS AVAILABLE ON REQUEST

BARNESBORO, PA.
NE 4 BARNESBORO 15 QUADRANGLE
N4037.5 W7845.7.5