


FIELD COPY

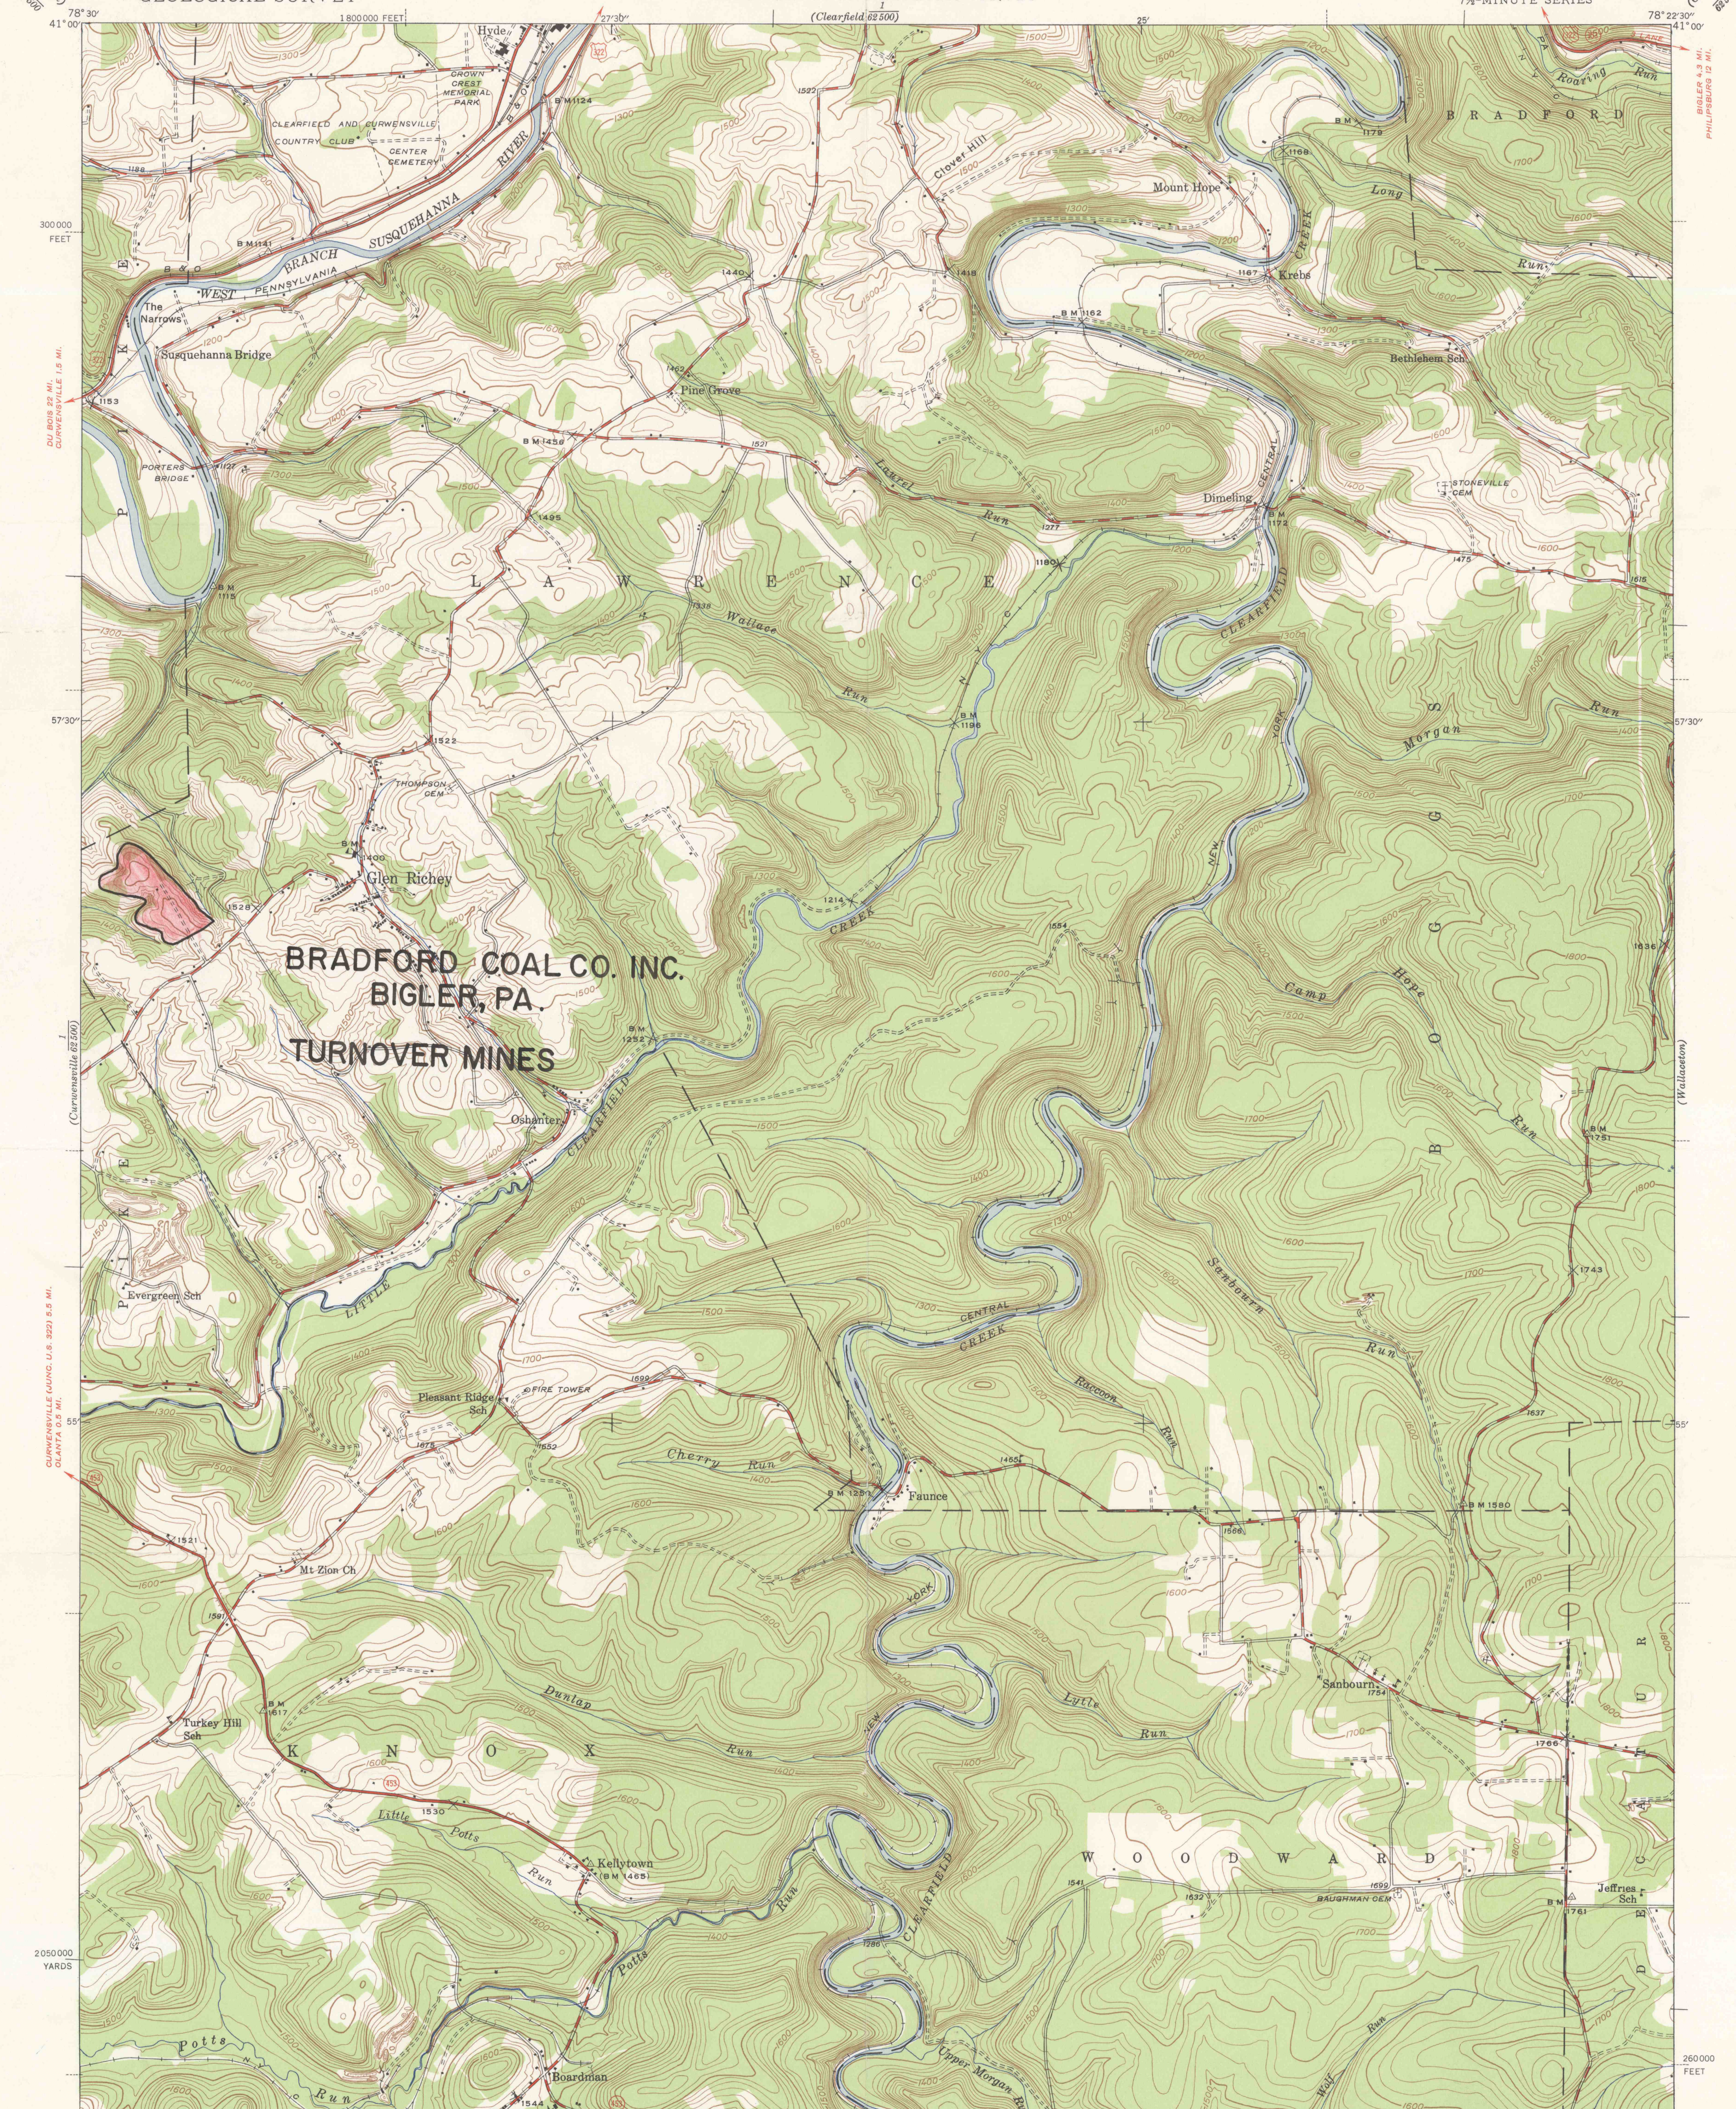


Mapped by the Geological Survey
1944

SCALE 1:24000

INTERIOR - GEOLOGICAL SURVEY, WASHINGTON, D. C. 1926
NAD 1927
Polyconic projection, 1927 North American datum
5000 yard grid based on U. S. zone system, B
10000 foot grid based on Pennsylvania (North)
rectangular coordinate system

ROAD CLASSIFICATION
Heavy-duty ——— LANE 16 LANE Light-duty ———
Medium-duty ——— LANE 16 LANE Unimproved dirt ———
U. S. Route State Route

**LAWRENCE TOWNSHIP
CLEARFIELD COUNTY
PERMIT NUMBER - 309-1
"E"-OR UPPER FREEPORT SEAM**

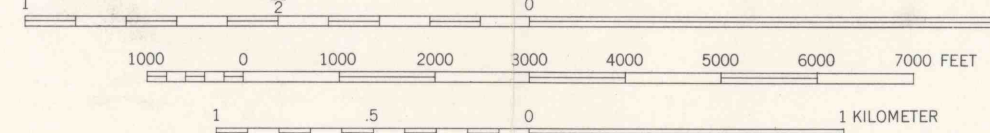

Contour interval 20 feet
Datum is mean sea level

GLEN RICHEY, PA.

N 4052.5 - W 7822.5 / 7.5
1944

FOR SALE BY U. S. GEOLOGICAL SURVEY, WASHINGTON 25, D. C.
A FOLDER DESCRIBING TOPOGRAPHIC MAPS AND SYMBOLS IS AVAILABLE ON REQUEST