


Mapped, edited, and published by the Geological Survey
Control by USGS and USC&GS
Topography by photogrammetric methods from aerial
photographs taken 1958. Field checked 1961
Polyconic projection. 1927 North American datum
10,000-foot grids based on Pennsylvania coordinate system,
south and north zones.
1000-meter Universal Transverse Mercator grid ticks,
zone 17, shown in blue.
Red tint indicates areas in which only landmark buildings are shown
Fine red dashed lines indicate selected fence and field lines where
generally visible on aerial photographs. This information is unchecked

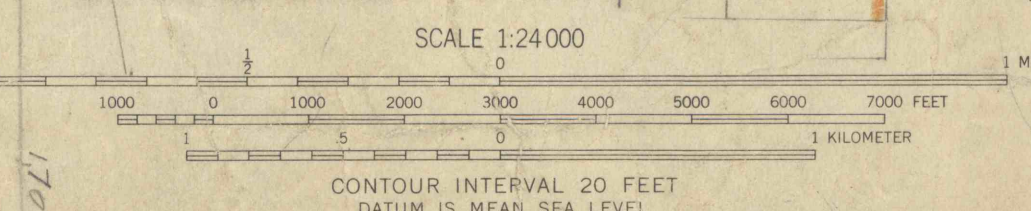

ROAD CLASSIFICATION
Heavy-duty ————— Light duty —————
Medium-duty ———— Unimproved dirt ————
U.S. Route ————— State Route —————

THIS MAP COMPLIES WITH NATIONAL MAP ACCURACY STANDARDS
FOR SALE BY U.S. GEOLOGICAL SURVEY, WASHINGTON 25, D.C.
A FOLDER DESCRIBING TOPOGRAPHIC MAPS AND SYMBOLS IS AVAILABLE ON REQUEST

BARNESBORO, PA.
NE 4 BARNESBORO 15' QUADRANGLE
114037.5—W7845.7.5
1961

Victor 179 min
21 AC.
COVERS
MARGA GRAY
ANNA BRUNO
ANNIE RIEG
EUG. MILLER
EUG. J. KLINE
400000m N. MICHAEL GRAY
A.P. WYLAND
MAYE SATUR
ELMA J. FARR
MARIA COSTELLA
RESIDUE OF
JOHN B. MILLER
TRACT AFTER
DEDUCTING 3.2 AC
ACQUIRED BY
SPANGLER BOROUGHS