


U.M. TORTIMER
 SURVEYOR
 No. 517

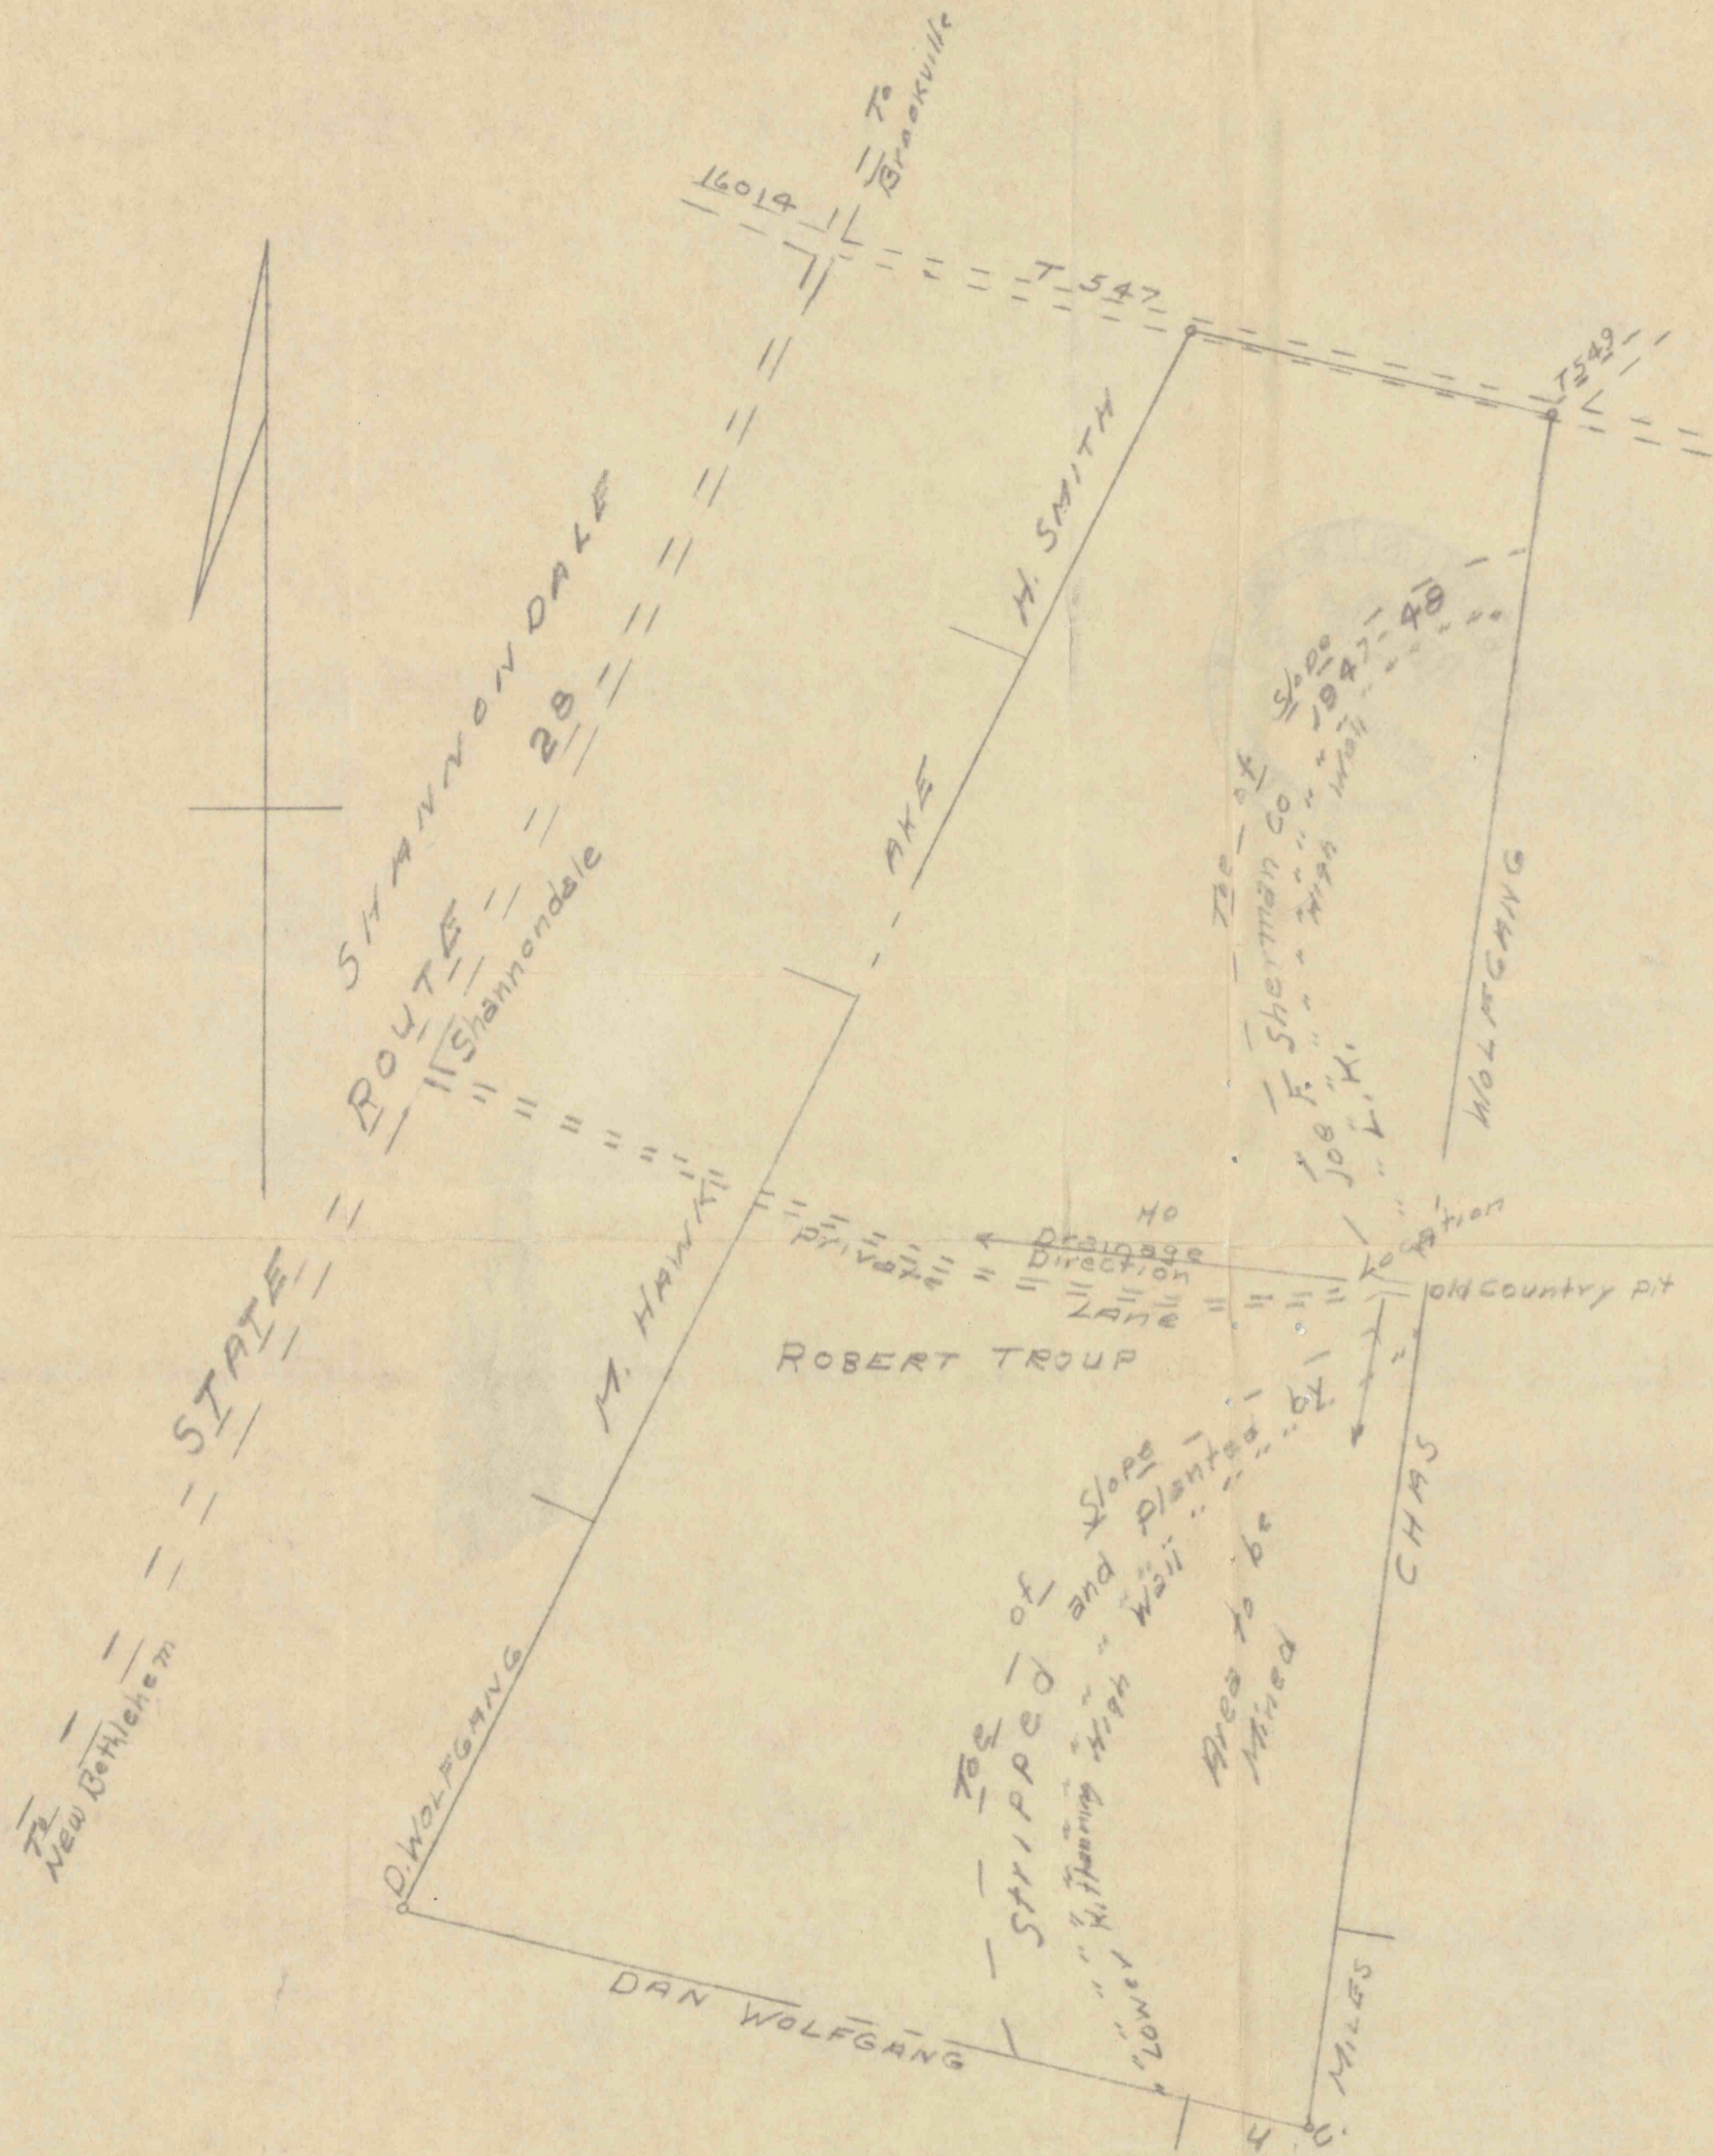

MAP SHOWING LOCATION OF PROPOSED DEEP MINE
 EDWARD TROUP, FAIRMOUNT CITY, PA. ON LAND
 OF ROBT TROUP, IN RED BANK TWP, CLARION CO. PA.
 LOWER KITTANNING COAL MEASURE
 Scale 1" = 200'

JAN 6 1956

BY T.M. T.M. T.M. TORTIMER R.S

DIST 4 1956