Bituminous
Mine Inspection Districts

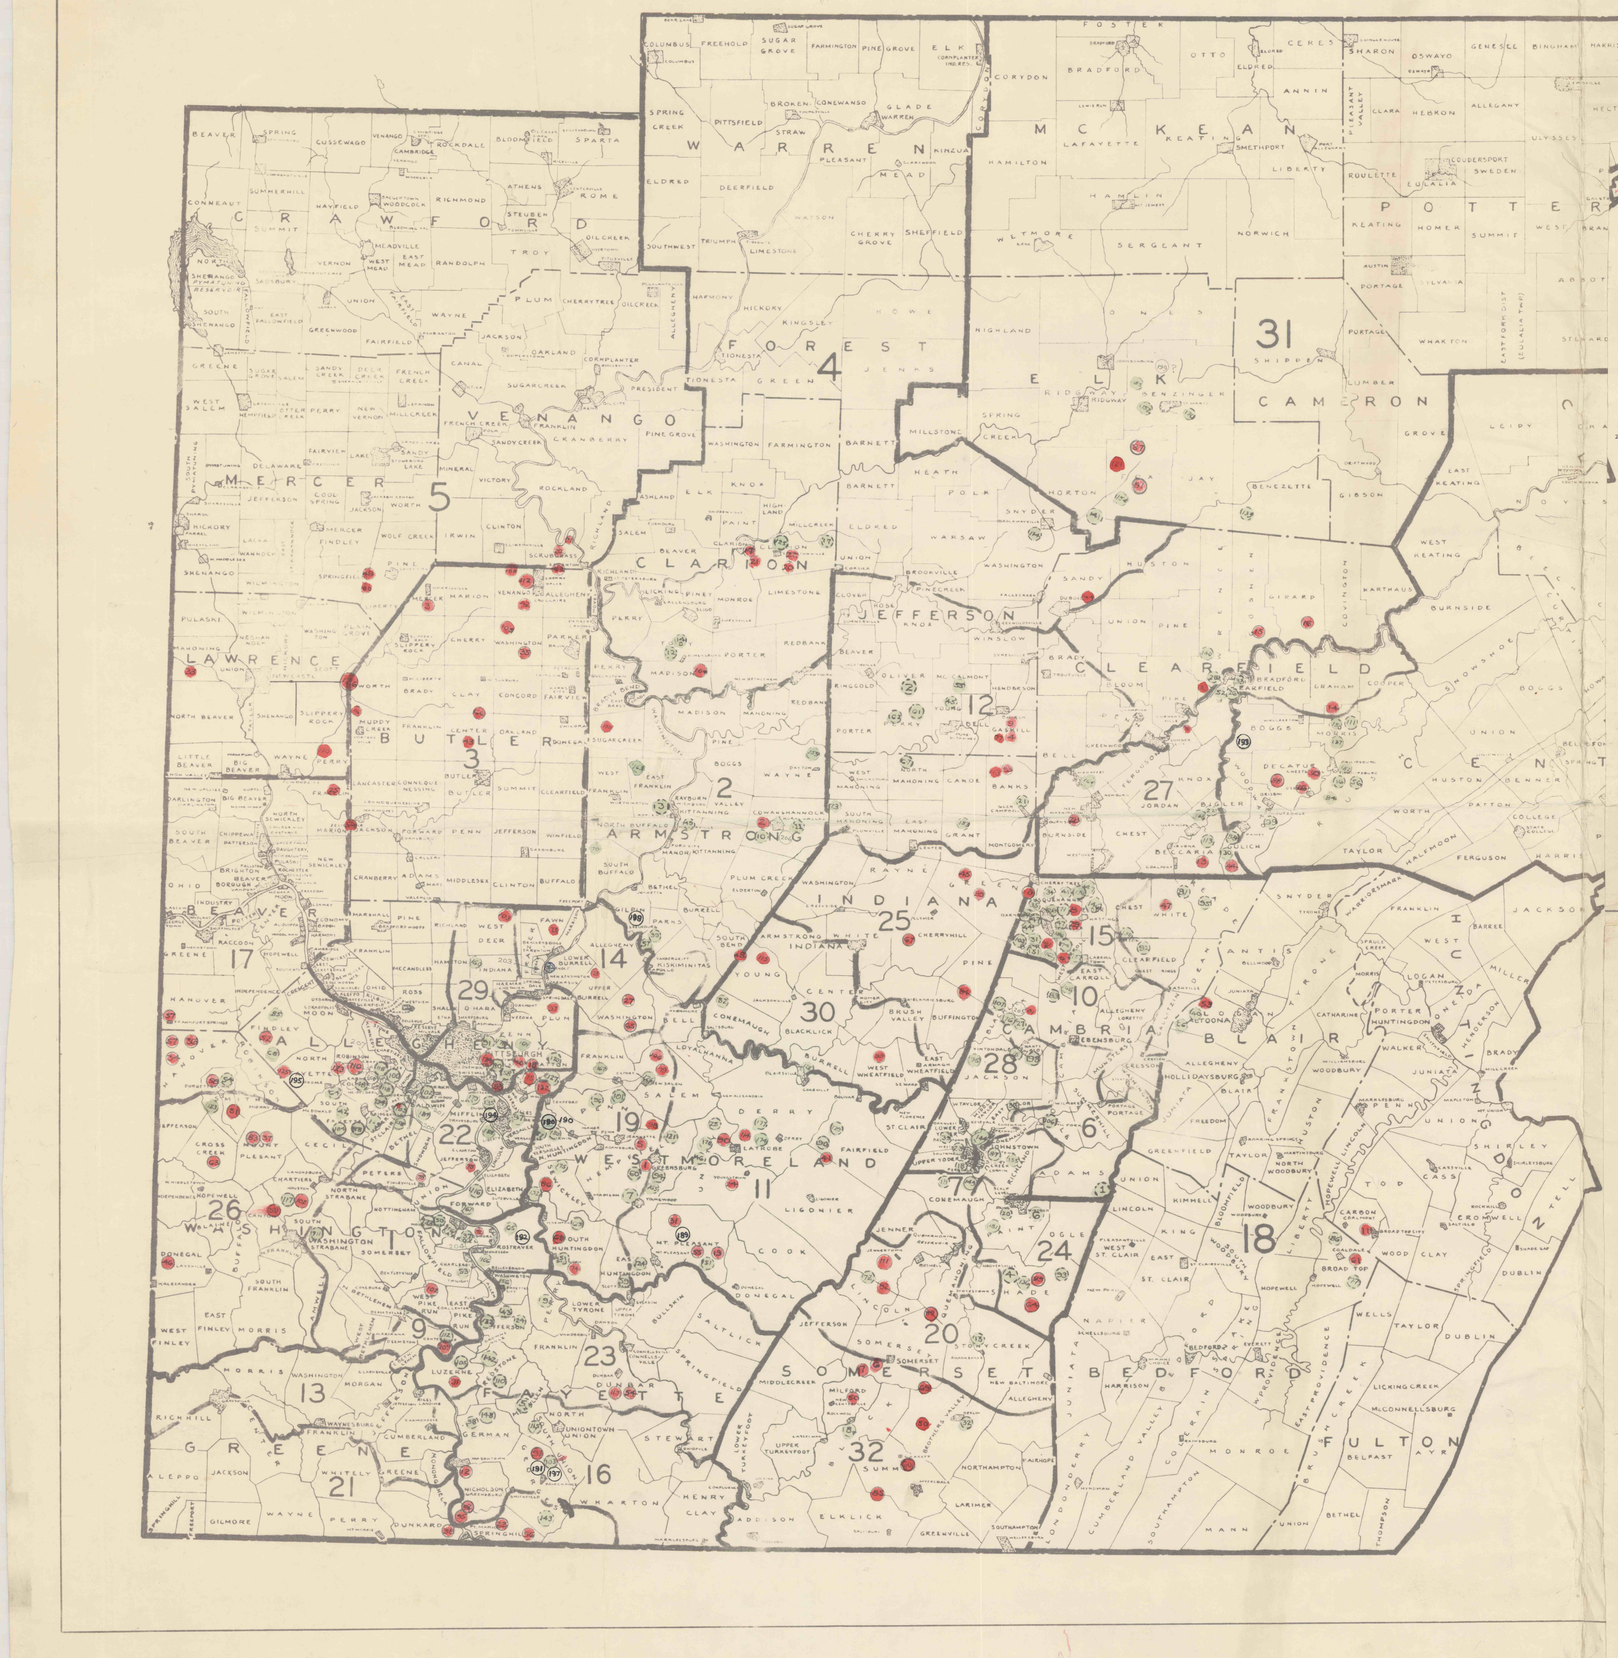

NOS	COUNTY	TOWNSHIP	CONTRACTOR	ACRES	CUBIC YARDS	AMOUNT
		Southwest				
1	WESTMORELAND	& GREENSBURG BOR.	THOS. MAJOLIE	SHAFT	1,000	2,400.00
2	ARMSTRONG	COWANSHANNOCK	WM. STITT	7.82	49,000	4,000.00
3	BUTLER	MERCER	MOTT & SHEDDEN	19.03	136,000	9,520.00
4	JEFFERSON	GASKILL	WM. GOETZ	17.78	109,932	6,900.00
5	WESTMORELAND	HEMPFIELD	STERLING EQUIP. CO.	10.00	113,300	6,793.00
6	SOMERSET	SOMERSET	MCDONALD & PAUL	15.15	234,260	24,950.00
7	SOMERSET	LAUREL RUN	LAUVER & SON	22.26	330,000	28,050.00
8	CAMBRIA	SUSQUEHANNA	STERLING EQUIP. CO.	30.43	150,000	8,850.00
9	JEFFERSON	GASKILL	CHAS. TRIMARCHI	18.27	138,000	7,854.80
10	CAMBRIA & INDIANA	SUS. & GREEN	STERLING EQUIP. CO.	10.33	50,000	4,140.00
11	HUNTINGDON	CARBON	JOSEPH BARNYAK	37.44	232,500	25,375.00
12	FAYETTE	NICHOLSON	W.A. WILSON	30.00	140,000	9,750.00
13	CLEARFIELD	BECCARIA	JOSEPH BARNYAK	18.00	160,000	10,800.00
14	CLEARFIELD	MORRIS & GRAHAM	CHAS. TRIMARCHI	19.00	170,000	* 9,476.00
15	CLEARFIELD	LAWRENCE	JOSEPH BARNYAK	48.00	420,000	38,950.00
16	CLEARFIELD	GIRARD	PAUL SMITH	16.00	145,000	8,900.00
17	CLARION	CLARION BORO.	K.T. STEWART	5.00	53,000	5,820.00
18	ALLEGHENY	MONROEVILLE BORO.	A.E. PROFIO	61.57	556,813	33,693.60
19	WESTMORELAND	MT. PLEASANT	A.E. PROFIO	50.00	513,000	35,898.50
20	CLARION	CLARION	C.H. SNYDER	31.00	172,000	11,180.00
21	CLARION	CLARION	C.H. SNYDER	33.00	392,000	25,480.00
22	CLARION	CLARION	JOHN BATES	100.50	378,000	23,250.00
23	FAYETTE	SPRINGHILL	JOSEPH BARNYAK	5.50	81,000	4,380.00
24	WESTMORELAND	UNITY	JOSEPH BARNYAK	16.20	193,000	11,200.00
25	BEAVER	FRANKLIN	H.D. MCBRIDE	62.50	600,000	30,950.00
26	CLEARFIELD	DECATUR	J.N. MONREAN	4.50	43,000	3,311.00
27	WESTMORELAND	WASHINGTON	SANCTIS CONST. CO	56.00	582,000	33,800.00
28	CLEARFIELD	BURNSIDE	A.E. PROFIO	19.16	140,000	7,693.00
29	CAMBRIA	SUSQUEHANNA	STERLING EQUIP. CO.	35.00	377,000	21,350.00
30	CLEARFIELD	DECATUR	J.N. MONREAN	18.00	207,000	12,420.00
31	WESTMORELAND	MT. PLEASANT	PA. RECLAMATION CO.	50.10	542,300	25,740.00
32	VENANGO	SCRUB GRASS	HARRY NEBEIDE	24.80	358,000	15,450.00
33	LAWRENCE	MAHONING	PILOT & SONS	27.18	320,000	11,550.00
34	WASHINGTON	HANOVER	J.N. MONREAN	20.82	340,000	23,800.00
35	BUTLER	WASHINGTON	J.N. MONREAN	41.80	650,000	31,200.00
36	WASHINGTON	HANOVER	WINDY HILL CONST. CO.	12.94	146,000	9,490.00
37	WASHINGTON	MT. PLEASANT	WINDY HILL CONST. CO.	6.13	83,000	5,950.00
38	GREENE	PA. RECLAMATION CO.	PA. RECLAMATION CO.	13.80	290,000	13,578.00
39	WASHINGTON	CANTON & CHARTIERS	W.A. WILSON	31.00	358,000	3,450.00
40	ALLEGHENY	MONROEVILLE BORO.	A.E. PROFIO	24.80	478,000	25,864.00
41	WESTMORELAND	UNITY & SALEM	WINDY HILL CONST. CO.	86.24	1,900,000	57,751.00
42	BUTLER	VENANGO	SOLOMON & TESLOVICH	40.18	2,100,000	57,750.00
43	BUTLER	CENTER	WINDY HILL CONST. CO.	29.50	413,000	13,440.00
44	CLEARFIELD	GULICH	JACKSON MONREAN	100	103,120	4,000.00
45	INDIANA	GREEN	JACKSON MONREAN	21.40	300,000	8,580.00
46	WASHINGTON	DONEGAL	HELEN PROFIO	SHAFT	900	2,250.00
47	CAMBRIA	SUS. & WHITE	PA. RECLAMATION CO.	27.20	377,000	17,440.00
48	ARMSTRONG	& BOGGS TWPS.	W.A. STITT	43.48	765,000	18,000.00
49	MERCER	SPRINGFIELD & PINE	HELEN PROFIO	73.50	1,425,000	49,500.00
50	SOMERSET	MILFORD & BOGGS TWPS.	C.L. WAGNER	41.30	537,000	18,500.00
51	WASHINGTON	SMITH	TONY CARUSO	105.51	1,485,521	52,120.60
52	ALLEGHENY	FINDLEY	C.L. WAGNER	132.80	2,056,000	49,950.00
53	BLAIR	LOGAN	MEINTOSH COAL CO.	160.48	2,610,000	88,450.00
54	FAYETTE	DUNBAR	FORD & GASKILL	77.13	1,132,503	34,750.00
55	WESTMORELAND	MT. PLEASANT	C.L. WAGNER	62.85	751,420	22,500.00
56	FAYETTE	SPRINGHILL	SOLOMON & TESLOVICH	13.00	130,000	4,500.00
57	WASHINGTON	SMITH & HANOVER	TONY CARUSO	73.83	1,125,950	25,550.00
58	BUTLER	SMITH	JACKSON MONREAN	25.50	352,000	33,000.00
59	SOMERSET	JACKSON TWNSHIP	MEINTOSH COAL CO.	114.46	1,747,300	19,250.00
60	SOMERSET	SUMMIT	WINDY HILL CONST. CO.	59.48	827,100	23,385.90
61	BEDFORD	BROAD TOP	C.L. WAGNER	8.11	124,000	5,460.00
62	VENANGO	ALLEN TWNSHP.	WINDY HILL CONST. CO.	23.60	318,100	3,567.00
63	WASHINGTON	CROSS CREEK	ANTHONY FRANTY	SHAFT	700	49,000.00
64	SOMERSET	SHADE	C.L. WAGNER	18.83	225,000	5,950.00
65	WESTMORELAND	WASHINGTON	WINDY HILL CONST. CO.	12.00	200,000	3,780.00
66	BUTLER	CENTER & CLAY	C.L. WAGNER	19.31	237,359	3,952.00
67	INDIANA	CHERRYHILL	A.R. WENCHISM	60.59	134,490	14,160.00
68	WESTMORELAND	S. HUNTINGDON	MEINTOSH COAL	36.43	705,030	15,180.00
69	SOMERSET	SOM. & BROS. VALLEY	C.L. WAGNER	43.50	329,915	4,450.00
70 E	CLEARFIELD	FIRE	WINDY HILL CONST. CO.	19.06	130,000	4,740.00
71	VENANGO	SCRUBGRASS	C.L. WAGNER	15.00	249,400	5990.00
72	WASHINGTON	CAROLL	YELINCK & SMAIL	FIRE		37,735.84
73	WESTMORELAND	CANAL	TRANSCONTINENTAL CO	13.08	200,480	5,984.00
74	WESTMORELAND	S. HUNTINGDON	S.S. BUFFENMYER	33.10	700,000	17,347.00
75	ALLEGHENY	MONROEVILLE BORO	TRANSCONTINENTAL CO	3.25	70,600	2,700.00
76 F	CLEARFIELD	LAWRENCE	HARTMAN BROS. CONST	7.62	98,600	1,193.70
77	JEFFERSON	GASKILL	MPINTOSH COAL CO	47.42	812,600	14,250.00
78 P	WASHINGTON	UNITY & JEFFERSON	WAGNER & HARTLE INC	68.00	504,000	19,250.00
79	WESTMORELAND	SALEM	WAGNER & HARTLE INC	30.08	405,480	11,850.00
80	MERCER	PINE-SHENFIELD-LIBERTY	CANCELLED			
81	ELK	FOX	FRED V. LOCEY	169.00	3,000,000	
82	SOMERSET	JENNER & LINCOLN	TRANSCONTINENTAL CO.	49.17	571,500	12,000.00
83	WASHINGTON	MT. PLEASANT	TRANSCONTINENTAL CO.	94.67	970,100	25,750.00
84	INDIANA	PINE & BUFFINGTON	JEFFERSON C.& CONST. CO	37.56	303,000	7,500.00
85	SOMERSET	SUMMIT & ELKLICK	MEINTOSH COAL CO.	40.50	440,000	19,300.00
86	WESTMORELAND	SEWICKLEY	WAGNER & HARTLE INC	90.47	640,100	21,900.00
87	ELK	FOX	N.E. FOX	2SHAFTS	1,343	2,812.28
88	CLEARFIELD	DECATUR *Honing	TRANSCONTINENTAL C.CO.	6.00	86,000	2,300.00
89	SOMERSET	SUMMIT & LARIMER	JACKSON MONREAN	22.45	297,000	7,500.00
90	WESTMORELAND	UNITY	WAGNER & HARTLE INC.	27.61	311,300	13,450.00
91	FAYETTE	LUZERNE-GEORGES	TCLINEK & SMAIL	FIRE		32,111.00
92	FAYETTE	SPRINGHILL-NICHOLSON	SOLOMON-TESLOVICH	21.84	363,900	10,900.00
93	ALLEGHENY	MONROEVILLE BORO.	H.E. FOX	31.03	326,000	13,330.00
94	CLEARFIELD	SANDY	MPINTOSH COAL CO.	SHAFTS	7.851	5,978.00
95	FAYETTE	SPRINGHILL	WAGNER & HARTLE INC.	29.78	511,650	29,500.00
96			CANCELLED			
97	ALLEGHENY	PLUM BOROUGH	H.E. FOX	54.30	496,000	13,800.00
98	WESTMORELAND	MENNFIELD	MSINTOSH COAL CO	13.00	203,000	5,800.00
99	INDIANA	SOUTH BEND &	WAGNER & HARTLE INC.	50.26	544,000	13,450.00
100	ARMSTRONG	QUEAR CREEK	MPINTOSH COAL CO.	16.68	244,000	7,286.00
101 A	CAMBRIA	CONEMAUGH & SUSQUEHANNA	WAGNER & HARTLE INC	32.00	442,000	12,250.00
102 F	WASHINGTON	SOMERSET	WAGNER & HARTLE INC.	16.65	235,000	9,280.00
103	ALLEGHENY	WEST DEER	H.E. FOX	61.43	369,180	24,400.00
104	CLARION	MADISON	JACKSON MONREAN	23.85	231,600	7,000.00
105	BUTLER	WASHINGTON	EDWARD MCGRADY & SON	12.07	107,000	4,923.00
106	WESTMORELAND	SEWICKLEY	WAGNER & HARTLE INC.	30.85	315,000	9,450.00
107			CANCELLED			
108	JEFFERSON & BUTLER	CLINTON & WASHINGTON	WAGNER & HARTLE	37.60	650,000	17,450.00
109	WASHINGTON	CENTERVILLE BORO	S & C DEMOLITION CO	CAVES	12,900	* 2,893.25
110	ALLEGHENY	COLLIER & ROBINSON	WAGNER & HARTLE	50.00	737,275	14,250.00
111	SOMERSET	JENNER	PA. RECLAMATION CO.	13.15	212,150	5,700.00
112	BUTLER	CHERRY VALLEY BORO	EMRACKEN CONST. CO	21.70	320,000	7,030.00
113	INDIANA	BANKS	WAGNER & HARTLE	8.10	110,000	4,850.00
114	WESTMORELAND	DERRY	LAUREL VALLEY CONSTR	10.00	160,000	5,489.00
115	INDIANA	YOUNG	SOLOMON-TESLOVICH	111.00	1,865,000	77,777.00
116	BUTLER	MUDDY CREEK	SOLOMON-TESLOVICH	8.60	83,000	2,890.00
117	FAYETTE	DUNBAR	SOLOMON-TESLOVICH	8.20	80,000	3,400.00
118 A	LAWRENCE	PERRY	H.D. MCBRIDE	30.00	327,000	
119 A	BUTLER	CHERRY VALLEY BORO	CANCELLED 10/67	9.70	125,000	
120	LAWRENCE	PERRY	TRANSCONTINENTAL CO.	30.00	327,000	10,925.00
121	ELK	FOX	TRANSCONTINENTAL C.CO.	33.27	675,700	12,130.00
122	ALLEGHENY	MONROEVILLE	WAGNER & HARTLE	15.50	147,900	4,449.00
123	ALLEGHENY	FINDLEY & JEFFERSON	WAGNER & HARTLE	37.76	343,000	9,850.00
124	ALLEGHENY	MONROEVILLE	WAGNER & HARTLE	2.70	40,700	2,650.00
125	ALLEGHENY	NORTH FAYETTE	TRANSCONTINENTAL CO.	21.00	236,000	9,750.00
126	BUTLER	WORTH & CRANBERRY	WAGNER & HARTLE	68.88	823,000	23,450.00
127	FAYETTE	GEORGES	FRANK J. TAKOCH	17.00	165,000	
128	ARMSTRONG	PARKER TP.		32.10	369,200	
129	WASHINGTON	FREDERICKTOWN		15.20	160,000	
130	BUTLER	MARION & CENTER & WORTH TWNSHPS				

B.D NOS	COUNTY	TOWNSHIP	ACRES	CUBIC YARDS	AMOUNT
1	CAMBRIA	A. DAVIS	6.00	13,000	$35.12
2	JEFFERSON	OLIVER	9.00	10,000	504.07
3	ARMSTRONG	E. FRANKLIN	6.00	13,000	387.38
4	SOMERSET	SHADE	16.00	80,000	3,831.52
5	FAYETTE	MENALLEN	7.65	78,880	3,234.76
6	SOMERSET	PAINT	SHAFT		70.86
7	WESTMORELAND	HEMPFIELD	5.42	96,000	1,602.05
8	SOMERSET	BLACK	0.90	12,585	451.90
9	FAYETTE	PERRY	2.60	35,700	2,077.34
10	ARMSTRONG	COWANSHANNOCK	CREEK		1,735.23
11	ARMSTRONG	COWANSHANNOCK	11.08	130,000	4,376.73
12	CLARION	TOBY	SHAFT		41.75
13	SOMERSET	STONYCREEK	25.20	192,000	3,819.15
14	CLARION	TOBY	SHAFT		41.75
15	CAMBRIA	BARR	SHAFT		113.93
16	CENTRE	EUSH	SHAFT		413.80
17	CLARION	CLARION	SHAFT		41.75
18	CAMBRIA	UPPER YODER	SUBSISTENCE		630.80
19	SOMERSET	HOLSOPPLE BORO	SEAL		419.32
20	SOMERSET	PAINT	11.90		5,800.32
21	INDIANA	BANKS	SHAFT		229.98
22	CLEARFIELD	BIGLER	SEAL		1,059.20
23	CAMBRIA	LOVEE YODER	CREEK		56.02
24	FAYETTE	JEFFERSON	SHAFT		171.36
25	WESTMORELAND	UNITY	FIRE		6,585.90
26	CLEARFIELD	CLEARFIELD BORO	SEAL		183.20
27	CAMBRIA	BLACKLICH	SEAL	30.24	292,000 7,823.71
28	CLEARFIELD	CLEARFIELD BORO.	SEAL		172.56
29	CAMBRIA	BARNESBORO BORO.	SHAFT		170.15
30	CLEARFIELD	MADERIA	SEAL		234.44
31	CAMBRIA	DARE	SEAL		216.44
32	SOMERSET	BROTHERS VALLEY	SHAFT		148.37
33	CLEARFIELD	CLEARFIELD BORO	SEAL		270.34
34	CAMBRIA	SUSQUEHANNA	SHAFT	380	140.93
35	CAMBRIA	SUSQUEHANNA	16.72	X 230,000	4,304.87
36	CAMBRIA	S. TAYLOR	SUBSISTENCE	7.4	141.67
37	WASHINGTON	CARROLL	FIRE	700	340.67
38	FAYETTE	GEESMAN	FIRE	840	273.44
39	CAMBRIA	LOWER YODER	SEALS		503.78
40	BLAIR	LOGAN	30.50	X 625,000	18,987.65
41	CAMBRIA	SUSQUEHANNA	SEAL	110	45.84
42	ALLEGHENY	S. FAYETTE	SEAL	27,000	397.50
43	FAYETTE	JEFFERSON	SEAL	1,450	279.76
44	CAMBRIA	BARR	3.42	85,000	185.88
45	JEFFERSON	YOUNG	31.50	X 498,000	X 15,423.48
46	UNITY	UNITY	1.50	10,000	351.38
47	CAMBRIA	SUSQUEHANNA	45.85	651,160	19,920.04
48	ALLEGHENY	COLLIERS	SHAFT	150	183.20
49	ARMSTRONG	MANOR	SHAFT	255	290.97
50	WASHINGTON	CAROLL	9.00	25,300	2,329.41
51	WESTMORELAND	S. HUNTINGDON	42.32	FIRE PRO.	32,782.07
52	CLEARFIELD	CLEARFIELD BORO	SEAL		121.92
53	WASHINGTON	FALLOWFIELD	FIRE		5,258.90
54	WASHINGTON	SMITH	FIRE		1,039.51
55	JEFFERSON	MCCALMONT	4.40	X 55,000	1,328.20
56	CENTRE	RUSH	SHAFT	200	190.90
57	ARMSTRONG	PARK	SHAFT		122.70
58	ALLEGHENY	CHURCHILL BORO	SHAFT		121.92
59	WESTMORELAND	E. HUNTINGDON	CAVES		1,664.19
60	WESTMORELAND	PENN	FIRE	40,000	2,159.41
61	JEFFERSON	PERRY	FIRE	40,000	2,008.13
62	JEFFERSON	PERRY	FIRE	131,000	6,879.34
63	WESTMORELAND	S. HUNTINGDON	DRIFT		215.95
64	ALLEGHNEY	S. FAYETTE	SHAFT		323.17
65	WESTMORELAND	ROSTRAVER	SUBSISTENCE		145.68
66	BLAIR	LOGAN	SHAFTS		308.80
67	INDIANA	N. MAHONING	SHAFTS		192.93
68	ALLEGHENY	FINDLEY	DRAINAGE		1,032.88
69					
70	ARMSTRONG	S. BUFFALO	DRIFTS		736.32
71	CAMBRIA	SUSQUEHANNA	4 SHAFTS		345.54
72	SOMERSET	JENNER & LINCOLN	SHAFT		732.48
73	INDIANA	S. MAHONING	SHAFT		152.00
74	CAMBRIA	WEST CARROLL	24.2	330,000	FIRE 98
75	CAMBRIA	JACKSON	DRIFT		98.60
76	CAMBRIA	BLACKLICK	DRIFT		1,062.38
77	SOMERSET	BROAD TOP	SHAFT		210.30
78	CAMBRIA	CONEMAUGH	1 SHAFT	650	935.81
79	WASHINGTON	S. STRABANE	FIRE		10,416.25
80	ALLEGHENY	CHURCHILL BORO	SHAFT		350.44
81	CAMBRIA	READE & WHITE	DRIFTS	45	136.48
82	INDIANA	CRAWMAUGH	SEALS	1,700	551.76
83	CAMBRIA	CAMBRIA	SHAFT	500	133.58
84	CENTRE	EUSH	WATER DRAIN	7,000	551.35
85	ALLEGHENY	FINDLEY	DITCH		1,911.30
86	SOMERSET	BROAD TOP	DRIFTS		578.64
87	CAMBRIA	STONYCREEK	SEAL	30	159.92
88	ALLEGHENY	SCOTT	SHAFTS	1,350	894.10
89	CLEARFIELD	GULICH	SHAFT		2,271.34
90	WESTMORELAND	W. FRIEDLEY	DRIFT	30	289.38
91	ALLEGHENY	PENN HILLS	FIRE		11,854.24
92	CAMBRIA	CLEARFIELD	SEALS	2.050	511.99
93	SOMERSET	SHADE	SHAFT & DRIFT	300	115.78
94	WESTMORELAND	S. GREENSBURG BORO	DRIFTS	30	138.16
95	CAMBRIA	BEADE	3.00	26,000	608.74
96	WESTMORELAND	PENN	3.00	40,000	281.05
97	ALLEGHENY	WHITE OAK BORO	CAVES		216.72
98	CAMBRIA	NANTY-GLO BORO	DRIFT		99.60
99	CLEARFIELD	WOODVALE	4.00	X 37,000	992.76
100	ALLEGHENY	GREENTREE BORO	DRIFT		442.40
101	WESTMORELAND	PENN	1.00	12,000	841.40
102	ALLEGHENY	CASTLE SHANNON BORO	DRIFT		1,032.30
103	FAYETTE	GEORGES	FIRE	Re-Mining	1,977.54
104	ALLEGHENY	S. FAYETTE	2.00	20,328	1,606.81
105	FAYETTE	LUZERNE	SHAFT	3.570	1,570.36
106	CAMBRIA	SOUTH FORK BORO	DRIFT		1,891.62
107	CAMBRIA	BLACKLICK	DRIFT		169.44
108	CAMBRIA	PATTON BORO	DRIFTS & DRAINAGE		2,827.37
109	ALLEGHENY	MT. O. PARK	LAND		116.00
110	FAYETTE	GEDDES	DRIFT	1,100	544.00
111	CLEARFIELD	MORRIS Morgan	SHAFT	750	102.60
112	WASHINGTON	CENTERVILLE BORO	SHAFT	233	420.00
113	CLEARFIELD	BECCARIA	36.20	410,000	
114	JEFFERSON	Re-Mining & Fire Clay	SHAFT		73.98
115	FAYETTE	LUNDS & MENALLEN	FIRE		7,379.37
116	ALLEGHENY	FORWARD	FIRE		1,165.00
117	WASHINGTON	CHARTIERS	31.06	200	191.20
118	ALLEGHENY	SCOTT	CAVE	S	368.52 54
119	ALLEGHENY	GREENTREE BORO	CAVE		135.68
120	ALLEGHENY	MONROEVILLE	CAVES		305.20
121	WESTMORELAND	NEWFIELD	FIRE	500	679.90
122	WASHINGTON	CALEDONIA BORO	FIRE	5,000	378.64
123	WASHINGTON	MONONGAHELA	FIRE		1,151.84
124	WESTMORELAND	E. HUNTINGDON	FIRE		4,899.19
125	CLARION	STRATTANVILLE	21.00	335,000	9439.86
126	WESTMORELAND	SALEM TWP.	FIRE		5,329.13
127	ALLEGHENY	MONROEVILLE	CAVE		129.74
128	INDIANA	BLAIRSVILLE	FIRE		62,325.42
129	WESTMORELAND	FAIRFIELD	CAVE		120.10
130	CAMBRIA	PATTON BORO	DRIFT		356.73
131	CAMBRIA	SUSQUEHANNA	CAVE		311.81
132	WESTMORELAND	SEWICKLEY	SHAFT		767.63
133	BLAIR	BELLEVUE	138.0	81,000	5,869.14
134	ALLEGHENY	CRAFTON	CAVE		96.58
135	ALLEGHENY	MCKNIGHTON	CAVE		29.68
136	SOMERSET	SHADE	DRAINAGE		923.32
137	CLEARFIELD	MORRIS Morgan	SHAFT		1,502.50
138	CLEARFIELD	BIGLER	DRAINAGE		4,556.68
139	CAMBRIA	BARNESBORO	SEAL		4,610.62
140	CLEARFIELD	LAWRENCE	6.16	178,000	2,043.02
141	ELK	MORTON	CITY WATER		1,718.37
142	FAYETTE	RED STONE	SHAFT		380.64
143	FAYETTE	GEORGES	FIRE		3,034.34
144	CAMBRIA	DALE BOROUGH	DRAINAGE		1,147.26
145	ALLEGHENY	UPPER ST. CLAIR	DRIFTS		1,346.68
146	CAMBRIA	ELDER	DRIFTS		303.12
147	CAMBRIA	ELDER	DRIFT		165.14
148	FAYETTE	GERMAN	FIRE		16,928.35
149	CAMBRIA	DALE BORO	DRIFT		885.04
150	CLEARFIELD	MORRIS	CAVE		186.21
151	WESTMORELAND	MT. PLEASANT	SHAFTS		2,161.22
152	ELK	BENZINGER	2.70	21,900	731.77
153	INDIANA	GRANT	SEAL		5,785.81
154	ELK	FOX	CITY WATER		2,013.92
155	CAMBRIA	RICHLAND & SPENCER CREEK	CAVES		233.66
156	FAYETTE	WASHINGTON	SWIMMING		3,726.72
157	CAMBRIA	WEST CARROLL	CAVE		40.16
158	ALLEGHENY	BRIDGEVILLE	DRIFTS		1,492.72
159	ARMSTRONG	WAYNE	DRIFT		210.06
160	ALLEGHENY	INDIANA	SWIMMING		6,388.00
161	ALLEGHENY	FOREWARD	DRIFT		3,203.10
162	CAMBRIA	SUSQUEHANNA	SWIMMING		2,332.91
163	ARMSTRONG	EAST FRANKLIN	4 SHAFTS	732.000	Not Finished
164	CLEARFIELD	BELL & MAHAFFEY	SHAFTS		164.50
165	WESTMORELAND	S. GREENSBURG	SHAFTS		242.44
166	WESTMORELAND	MORGESSON	MINE FIRE		5,586.41
167	WESTMORELAND	FRANKLIN	GAS SEALED		1,336.72
168	CAMBRIA	EAST CARROLL	DRIFT		332.48
169	ALLEGHENY	MONROEVILLE	SWIMMING		1,283.00
170	ELK	BENZINGER	DRIFT		2,370.90
171	WESTMORELAND	NORTH HUNTINGDON	SHAFT		296.34
172	WESTMORELAND	CITY OF JEANNETTE	SUBSIDENCE		9,969.21
173	ALLEGHENY	MONROEVILLE	SWIMMING		127.76
174	WESTMORELAND	DERRY	SHAFTS		969.97
175	WESTMORELAND	SEWICKLEY	FIRE		1,742.60
176	WASHINGTON	MONONGAHELA	DRIFT		147.64
177	WESTMORELAND	DERRY	CAVE		77.36
178	WESTMORELAND	UNITY	CAVE		51.04
179	ALLEGHENY	CHURCHILL	CAVE		258.08
180	WESTMORELAND	N. HUNTINGDON	CAVE		211.36
181	SOMERSET	PAINT	CAVE		66.36
182	CENTRE	RUSH	DRAINAGE		Not Finished
183	WASHINGTON	SMITH	SHAFTS		388.06
184	ALLEGHENY	MUNHALL	SUBSIDENCE		1,049.19
185	ELK	BENZINGER	10.73	84,700	3,025.36
186	CAMBRIA	SUSQUEHANNA	DRAINAGE		2,729.18
187	ALLEGHENY	DUQUESNE	SUBSIDENCE		145.30
188	ALLEGHENY	WEST MIFFLIN	SHAFTS & DRIFTS		Not Finished
189	WESTMORELAND	MT. PLEASANT TWNSHP. & SOUTH HUNTINGDON TWP.	SHAFTS		296.20
190	WESTMORELAND	N. HUNTINGDON TWP.	CAVES		1,831.96
191	FAYETTE	GEORGES	FIRE		67.72
192	WESTMORELAND	ROSTRAVER	FIRE		1,367.90
193	CLEARFIELD	BOGGS	SHAFT & DRIFT	5.00	367.70
194	ALLEGHENY	DUQUESNE CITY	SUBSIDENCE		175.20
195	ALLEGHENY	VILLAGE OF SEWICKLEY & SOUTH HEIGHTS	SUBSIDENCE		1055.51
196	CLEARFIELD	BOGGS TOWNSHIP	FIRE	1.50	113.70
197	FAYETTE	GEORGES TOWNSHIP	FIRE	705.80	12,226.35
198	ARMSTRONG	KITTANNING TOWNSHIP	SEAL		893.06
199	ELK	BENZINGER TOWNSHIP	SEAL		169.80
200	ALLEGHENY	WEST DEER TOWNSHIP	CAVE		128.80
201	ALLEGHENY	CITY OF PITTSBURGH	SEAL		198.24
202	BEDFORD	BROAD TOP TOWNSHIP	SHAFTS & DRIFTS		Not Finished
203	ALLEGHENY	EAST DEER TOWNSHIP	SHAFTS & DRIFTS		25,727.50
204	WASHINGTON	CARROLL TOWNSHIP	TWO SHAFTS		249.92
205	CAMBRIA	TWIN ROCKS BLACKLICK