




Allison Engineering Co
October 1966

Allison No. 17 Mine
Mary G Hartman
Harold B. Hartman
Allison Engineering Co.
Charles Shirey
Budd B. Stewart
Properties

Prepared by
L. S. TAYLOR ENGINEERING
Clarion, Pennsylvania

Frank Sutton, Geographer in charge.
Topography by R. D. Cummin, R. H. Reineck, and E. W. McCrary.
Control by E. L. McNair and C. G. Anderson.
Surveyed in 1905-1907.

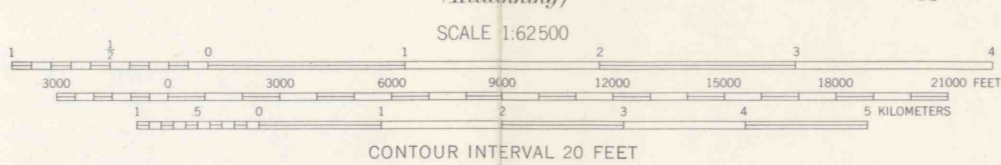

**TOBY TOWNSHIP
CLARION COUNTY
PERMIT NUMBER-147-1
"B"-OR LOWER KITTANNING SEAM**

FIELD COPY
L. S. TAYLOR ENGINEERING
Post Office Box 311
Clarion, Pennsylvania

P.A.
FOXBURG
N4100-W7930/15
1907

FOR SALE BY U.S. GEOLOGICAL SURVEY, WASHINGTON 25, D. C.
A FOLDER DESCRIBING TOPOGRAPHIC MAPS AND SYMBOLS IS AVAILABLE ON REQUEST