




B. & H. Coal Co
Central City.
B'-seam of Coal
Lower Kittanning
Located By
M. E. TREMEL
Eng. Reg. No.
13535

H. B. Marshall, Chief Geographer,
Frank Cutton, Geographer in charge,
Topography by Robert Muldrow, Oscar Jones,
E. E. Witherspoon, and E. D. Monroe.
Control by Geo. T. Hawkins and T. A. Green.
Surveyed in 1913-1914.

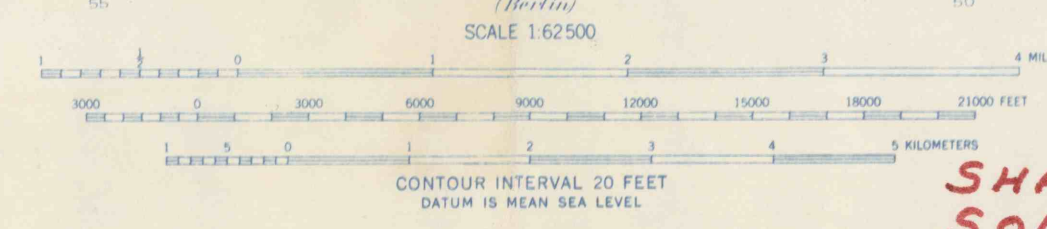

**SHADE TOWNSHIP
SOMERSET COUNTY
PERMIT NUMBER - 246-1
"B"-OR LOWER KITTANNING SEAM**

FOR SALE BY U. S. GEOLOGICAL SURVEY, WASHINGTON 25, D. C.
A FOLDER DESCRIBING TOPOGRAPHIC MAPS AND SYMBOLS IS AVAILABLE ON REQUEST

PA
WINDBER
H4000-W7846/16
1914