




*BANBRIK Coal Co.
Mine #1-
B'-COAL Seam
Lower Kittanning
Located BY
M.E. TRENEL
Engr. Reg. No. 13535*

R.B. Marshall, Chief Geographer.
Frank Sutton, Geographer in charge.
Topography by Robert Muldrow, Oscar Jones,
E.E. Witherspoon, and E.D. Monroe.
Control by Geo. T. Hawkins and T.A. Green.
Surveyed in 1913-1914.

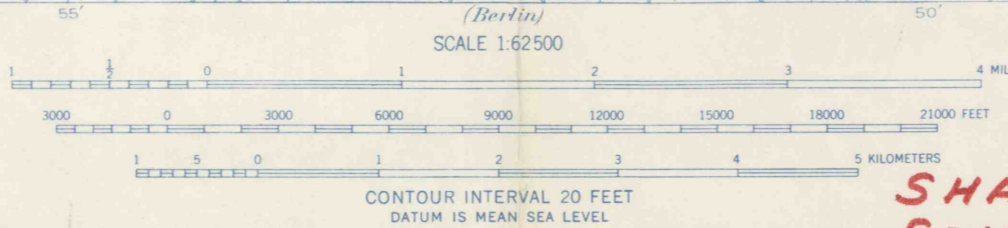

**SHADE TOWNSHIP
SOMERSET COUNTY
PERMIT NUMBER - 129-2A
"B"-OR LOWER KITTANNING SEAM**

FOR SALE BY U.S. GEOLOGICAL SURVEY, WASHINGTON 25, D. C.
A FOLDER DESCRIBING TOPOGRAPHIC MAPS AND SYMBOLS IS AVAILABLE ON REQUEST