


JENNER TOWNSHIP  
SOMERSET COUNTY  
PERMIT NUMBER - 91-1  
"E" - OR UPPER FREEPORT SEAM

UNITED STATES  
DEPARTMENT OF THE INTERIOR  
GEOLOGICAL SURVEY


STATE OF PENNSYLVANIA  
REPRESENTED BY THE  
DEPARTMENT OF INTERNAL AFFAIRS  
TOPOGRAPHIC AND GEOLOGIC SURVEY  
(New Florence)

PENNSYLVANIA  
SOMERSET QUADRANGLE

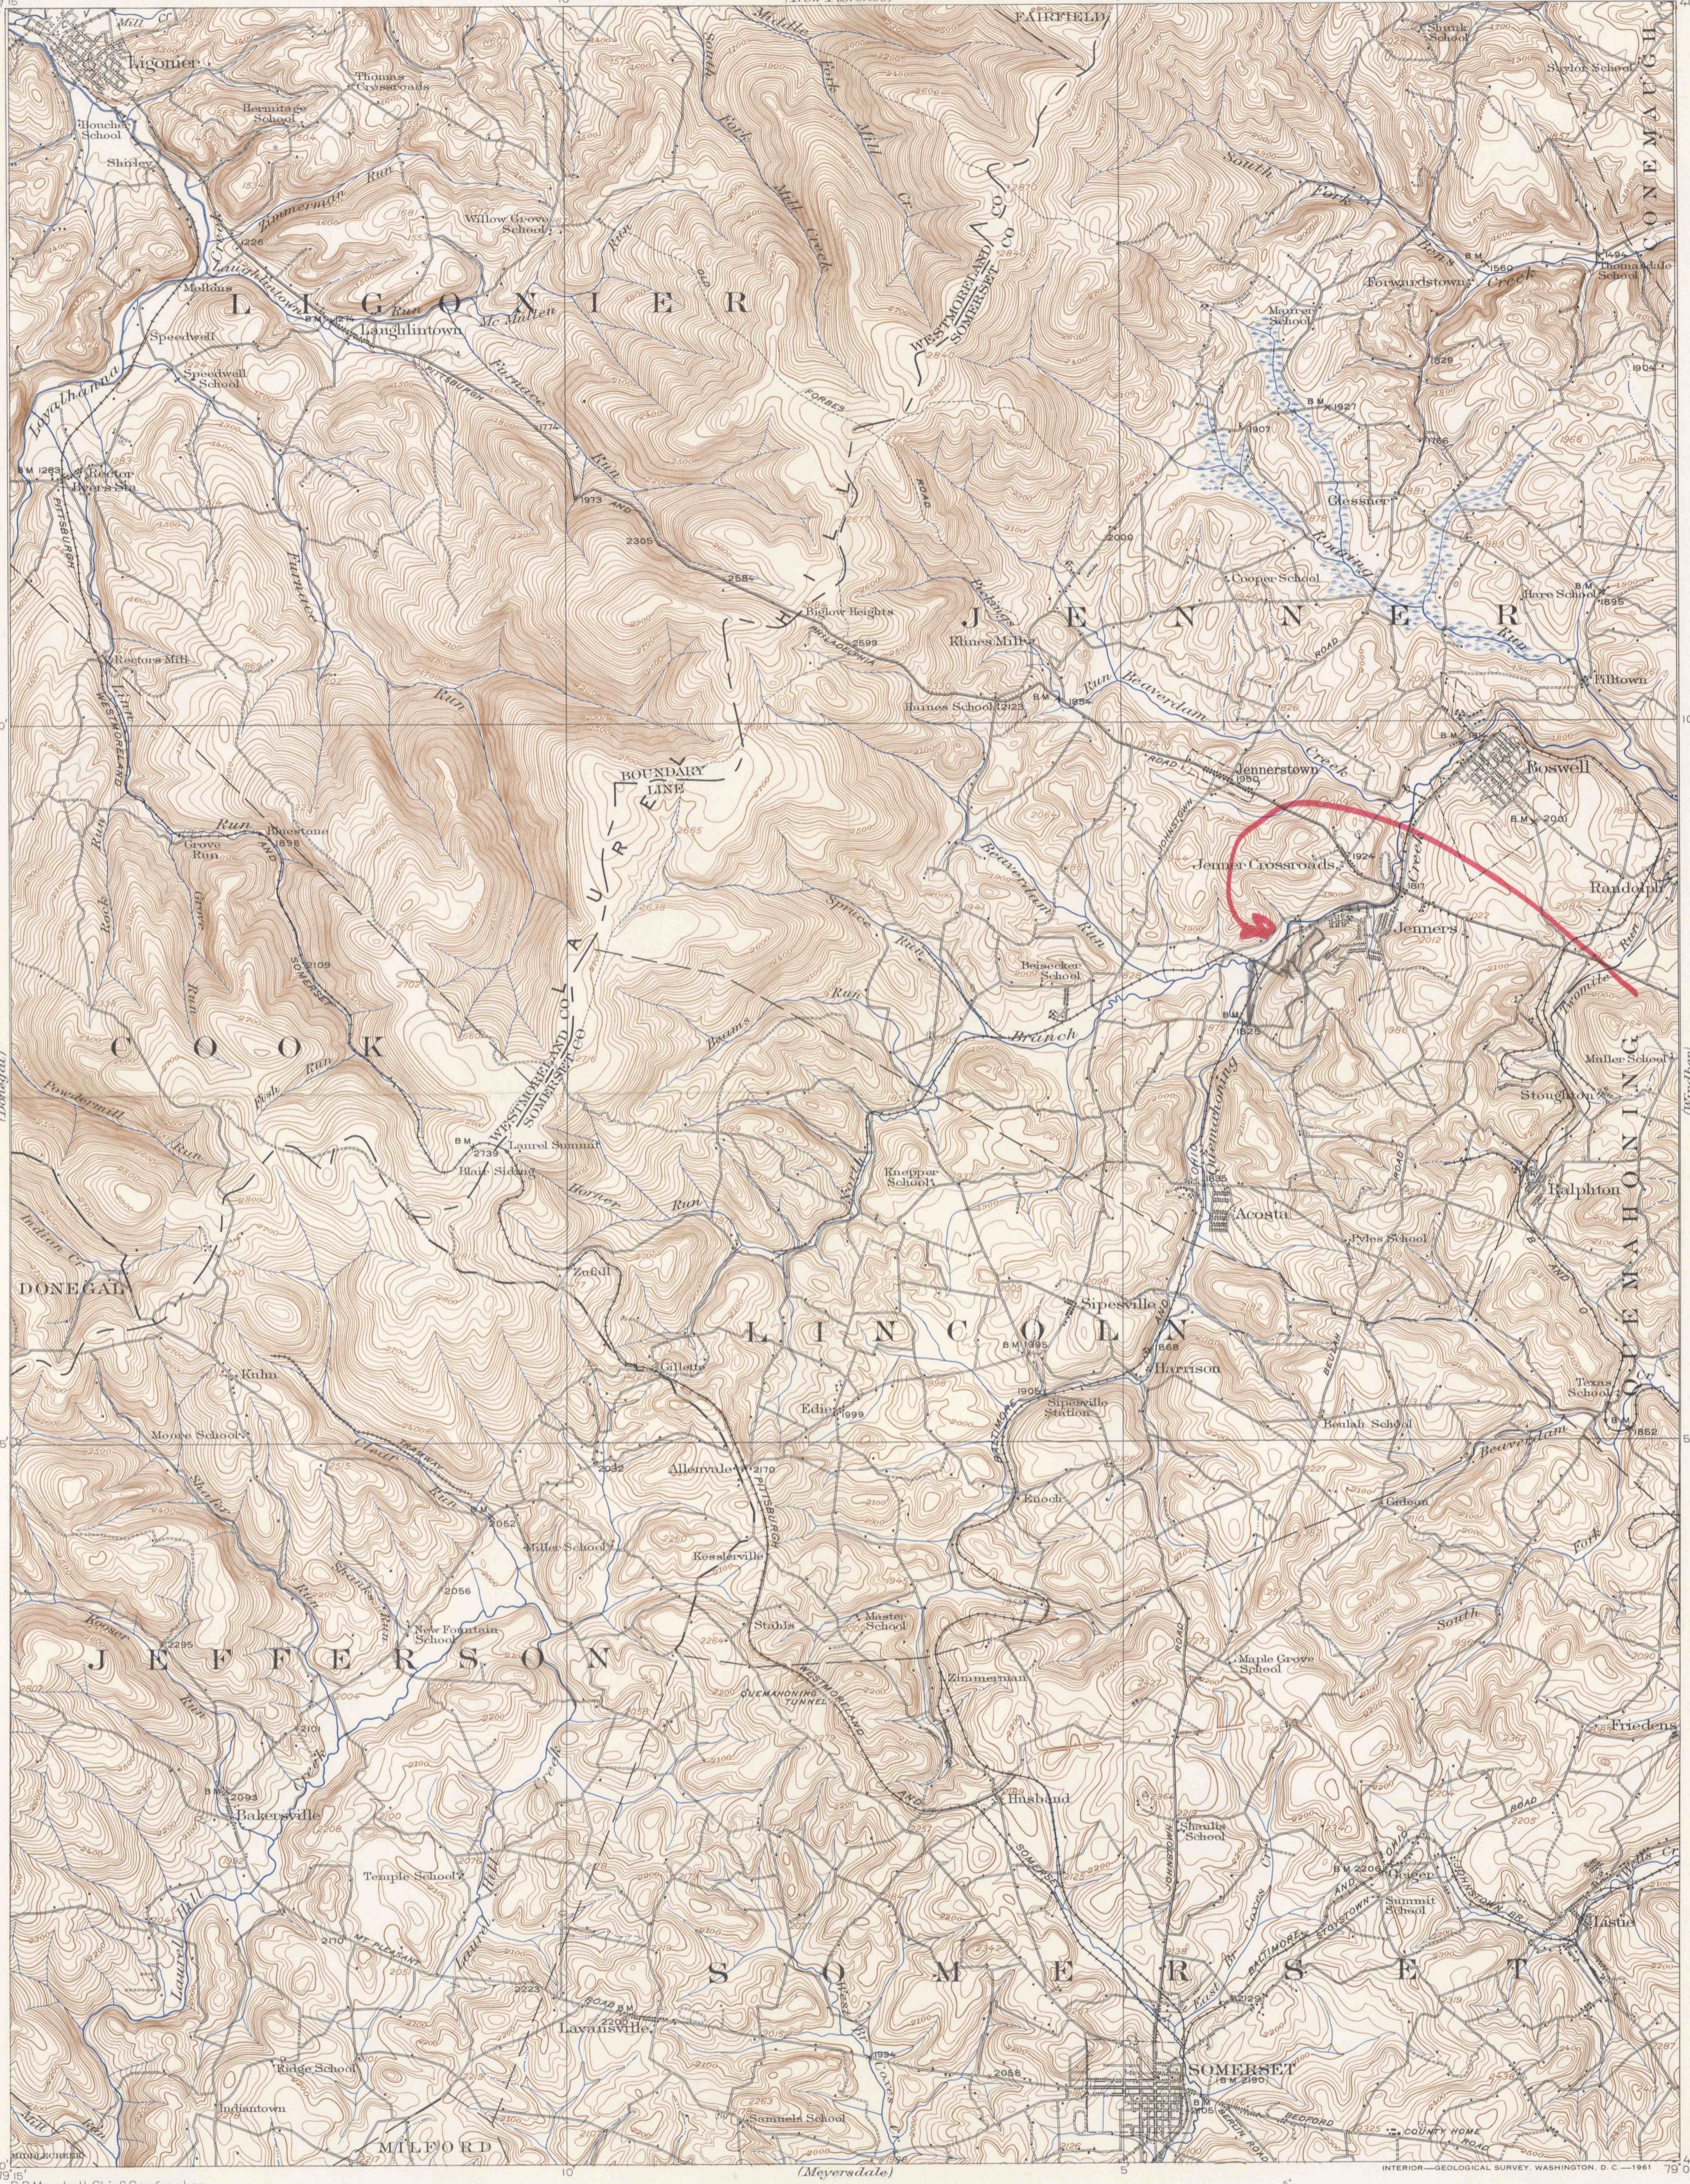

JOHN J. BAUGHMAN MINE  
E 2047  
E 14 & FRENCH  
SEPT 28, 1966

R.B. Marshall, Chief Geographer.  
Frank Sutton, Geographer in charge.  
Topography by Robert Muldrow, T.F. Slaughter, and F.W. Farnsworth.  
Control by Geo. T. Hawkins, L.F. Biggs, and T.A. Green.  
Surveyed in 1912-1913.

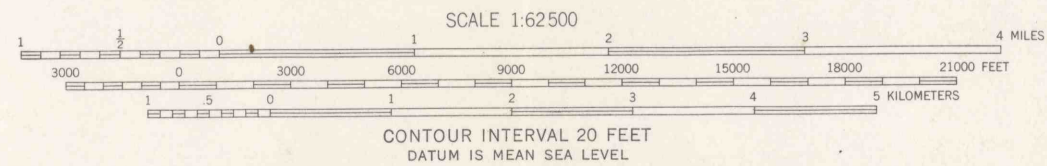

CONTOUR INTERVAL 20 FEET  
DATUM IS MEAN SEA LEVEL

APPROXIMATE MEAN  
DECLINATION 1913.

INTERIOR - GEOLOGICAL SURVEY, WASHINGTON, D. C. - 1961  
Polyconic projection. 1927 North American datum

SOMERSET, PA.  
N 4000 - W 7900 / 15

1913

FOR SALE BY U. S. GEOLOGICAL SURVEY, WASHINGTON 25, D. C.  
A FOLDER DESCRIBING TOPOGRAPHIC MAPS AND SYMBOLS IS AVAILABLE ON REQUEST