

**DUNKARD TOWNSHIP
GREENE COUNTY
PERMIT NUMBER - 115-1
PITTSBURGH SEAM**

FIELD COPY

UNITED STATES
DEPARTMENT OF THE INTERIOR
GEOLOGICAL SURVEY

STATE OF WEST VIRGINIA
REPRESENTED BY THE
GEOLOGICAL SURVEY


STATE OF PENNSYLVANIA
DEPARTMENT OF INTERNAL AFFAIRS
TOPOGRAPHIC AND GEOLOGIC SURVEY

WEST VIRGINIA-PENNSYLVANIA
MORGANTOWN QUADRANGLE



Topography by Frank Sutton, J.M. Whitman, Jr. and A.M. Walker.
Surveyed in 1900.
West Virginia portion revised in 1923 by E.J. Ireland.
Fayette County, Pa. part revised in 1931 by C.S. Wells

ROAD CLASSIFICATION
 HARD SURFACE ALL WEATHER ROADS DRY WEATHER ROADS
 Loose-surface, graded, or narrow hard-surface - - -
 U. S. Route State Route

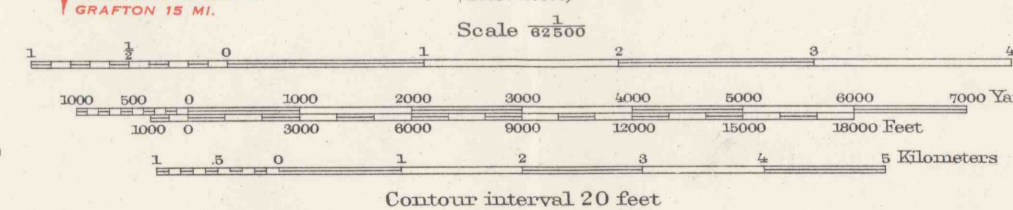

Polyconic projection, North American
5000 yard grid based upon U.S. Standard Datum
 OAKLAND, CALIF. COMMONWEALTH OF PENNSYLVANIA

FAYETTE ENGINEERING CO.
UNIONTOWN, PA.



FOR SALE BY U. S. GEOLOGICAL SURVEY, WASHINGTON 25, D. C.
 A FOLDER DESCRIBING TOPOGRAPHIC MAPS AND SYMBOLS IS AVAILABLE ON REQUEST