

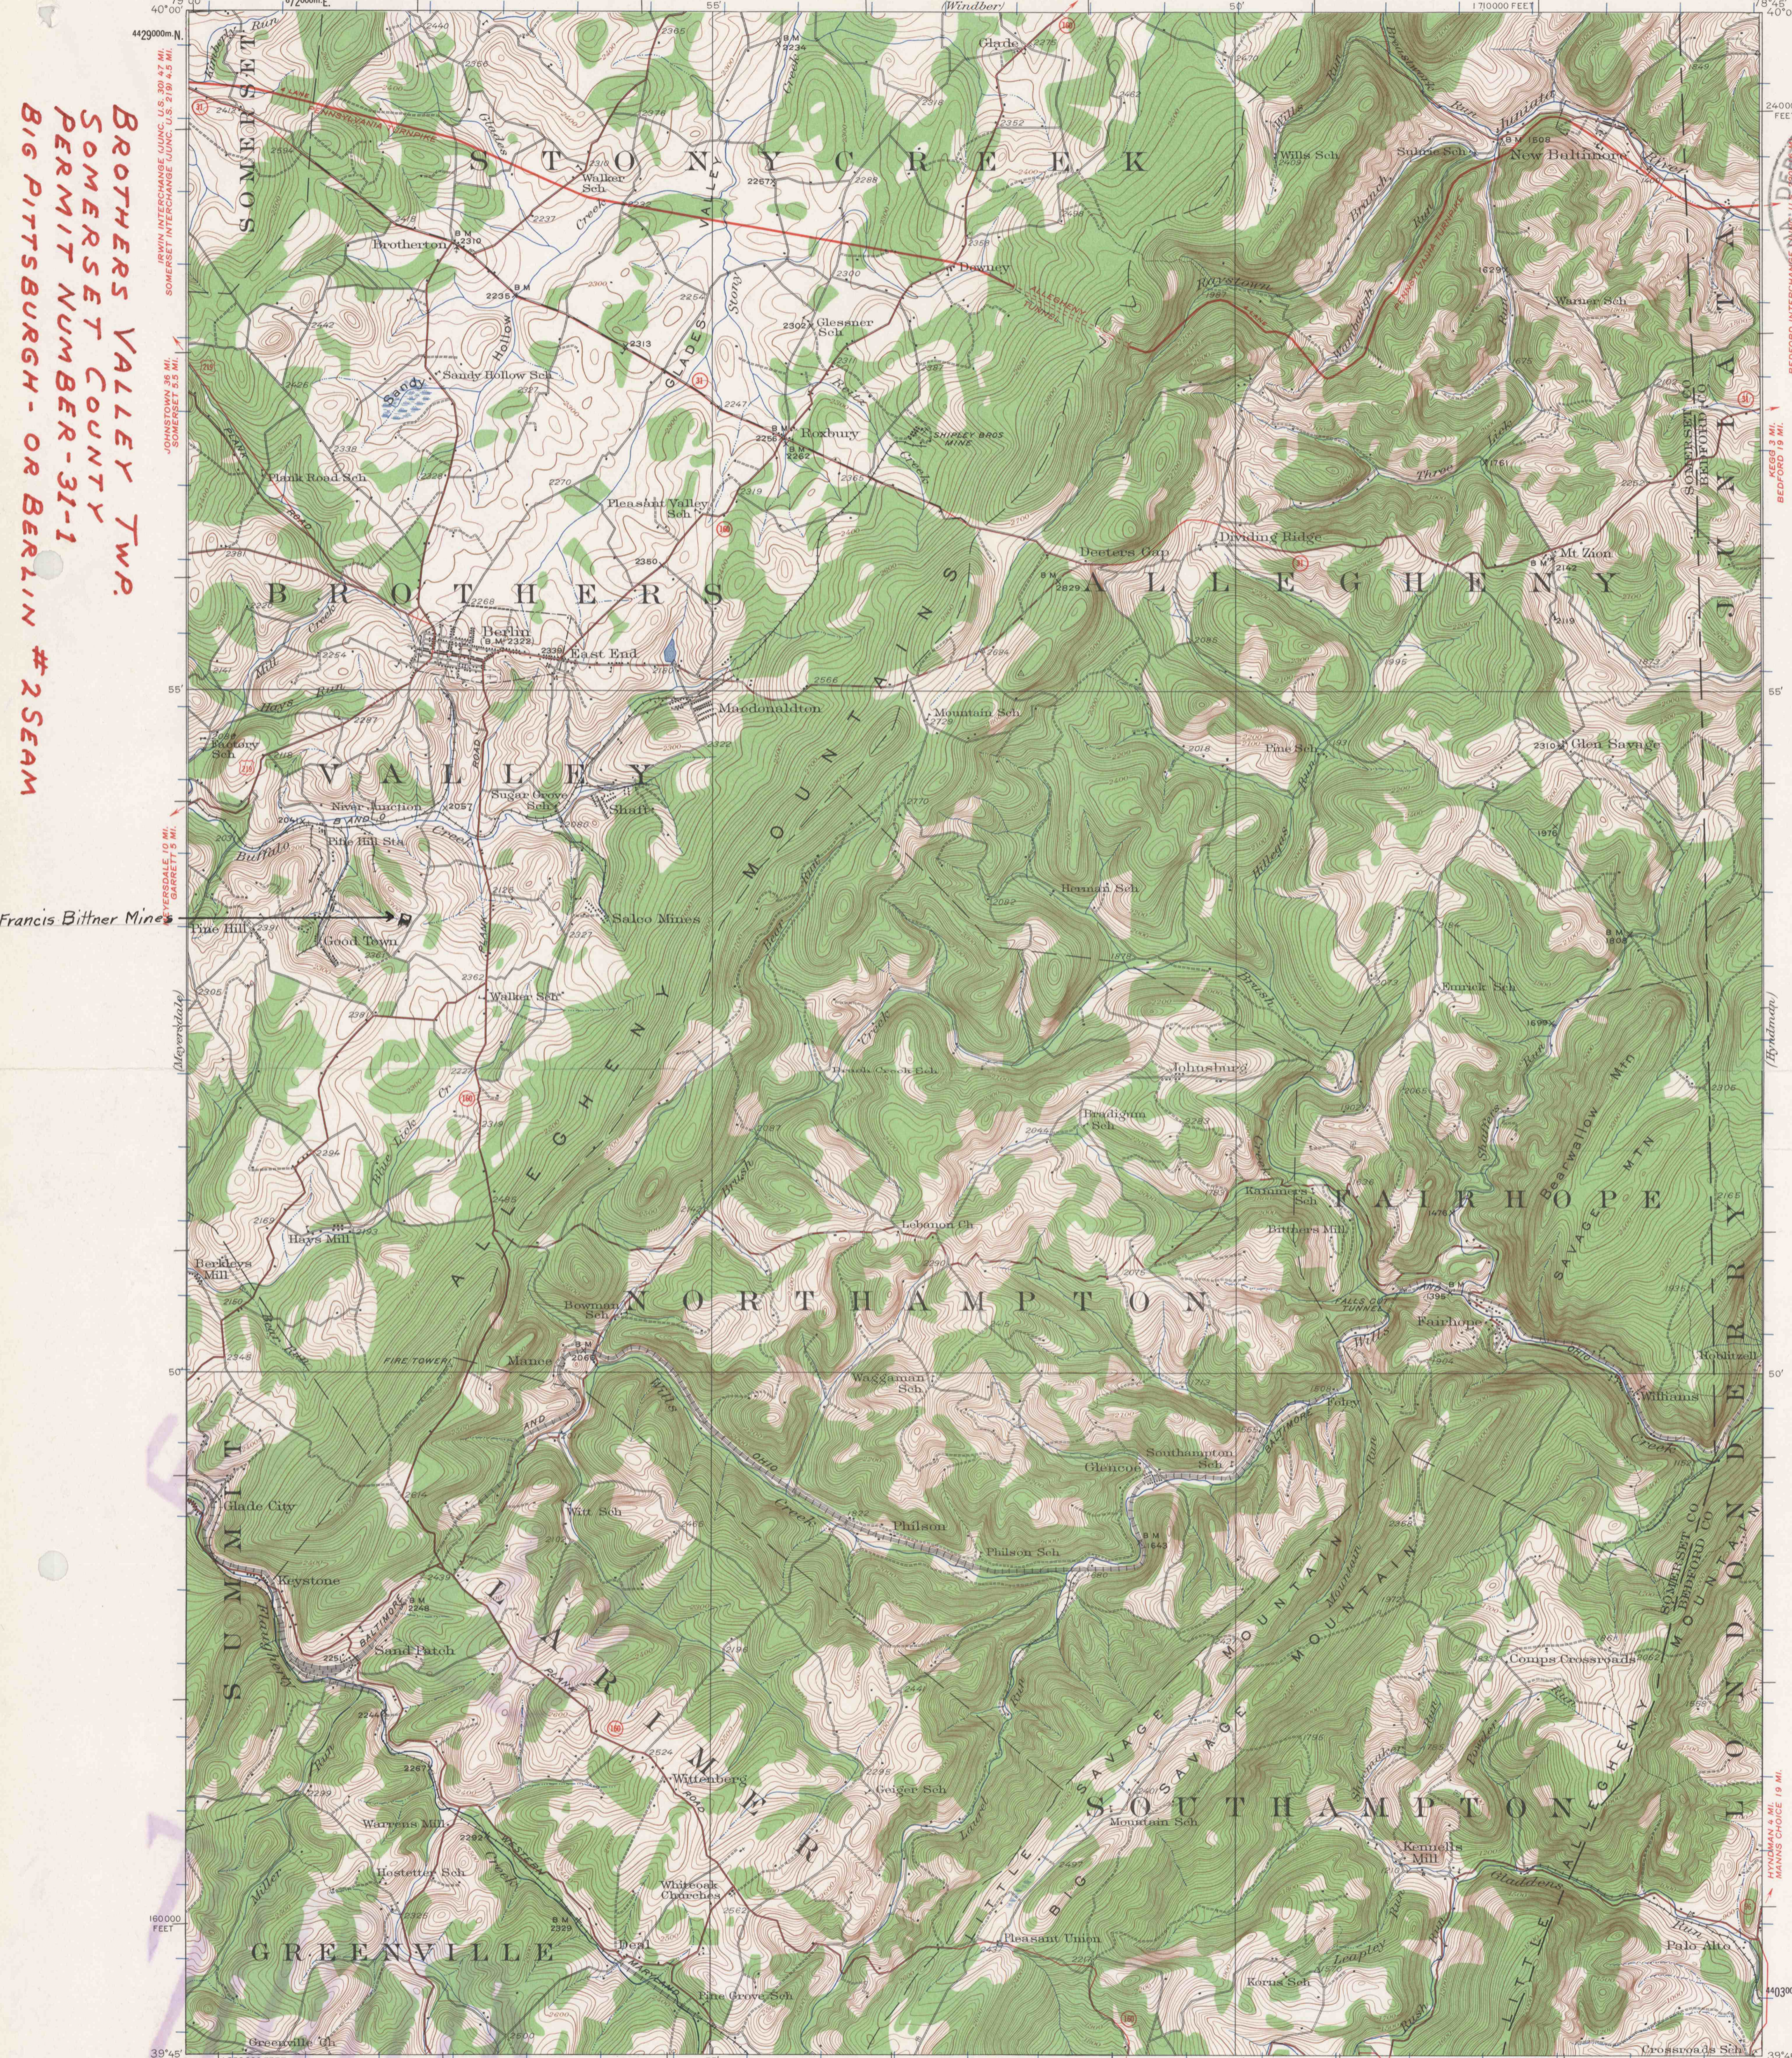


**BROTHERS VALLEY TWP.
SOMERSET COUNTY
PERMIT NUMBER-31-1
BIG PITTSBURGH - OR BERLIN #2 SEAM**

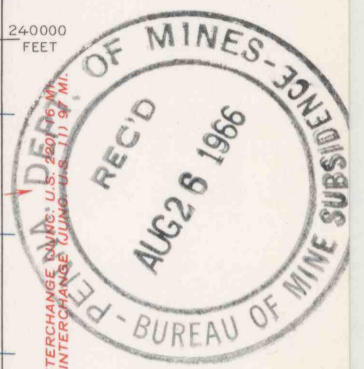

Topography by J.F. McBeth, M.A. Roudabush,
H.A. Bean, and Matt Daura
Surveyed in 1923

ROAD CLASSIFICATION
Heavy-duty ——— Light-duty - - - - -
Medium-duty ——— Unimproved dirt - - - - -
U.S. Route □ State Route ○

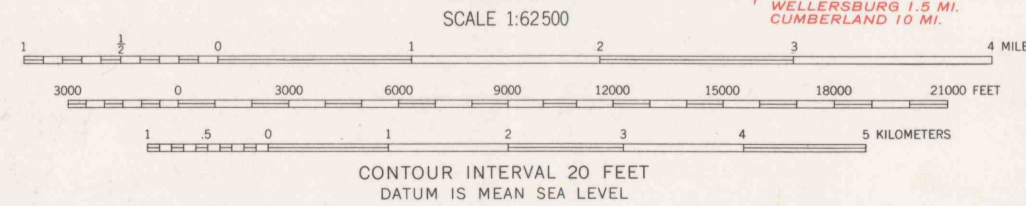

Interior-Geological Survey, Washington, D.C.—1922
MR 2434
Polyconic projection. 1927 North American datum
10 000-foot grid based on Pennsylvania (South)
rectangular coordinate system
1000-meter Universal Transverse Mercator grid ticks,
zone 17, shown in blue

BERLIN, PA.
N3945—W7845/15
1923

FOR SALE BY U.S. GEOLOGICAL SURVEY, WASHINGTON 25, D. C.
A FOLDER DESCRIBING TOPOGRAPHIC MAPS AND SYMBOLS IS AVAILABLE ON REQUEST