

UNITED STATES
DEPARTMENT OF THE INTERIOR
GEOLOGICAL SURVEY

STATE OF PENNSYLVANIA
REPRESENTED BY THE
DEPARTMENT OF INTERNAL AFFAIRS
TOPOGRAPHIC AND GEOLOGIC SURVEY


P A I N T T O W N S H I P
S O M E R S E T C O U N T Y
P E R M I T N U M B E R - 1 8 3 - 1
C - P R I M E O R U P P E R K I T T A N N I N G S E A M

PENNSYLVANIA
WINDBER QUADRANGLE



Ralph Bloom Jr.
Mine # 1.
Paint Twp.
Somerset Co.
Penna.
Located By
M.E. TREMEL, C. Eng.
Reg. No. 13535.

R.E. Marshall, Chief Geographer,
Frank Sutton, Geographer in charge,
Topography by Robert Muldrow, Oscar Jones,
E.E. Witherspoon, and E.D. Monroe.
Control by Geo. T. Hawkins and T.A. Green.
Surveyed in 1913-1914.

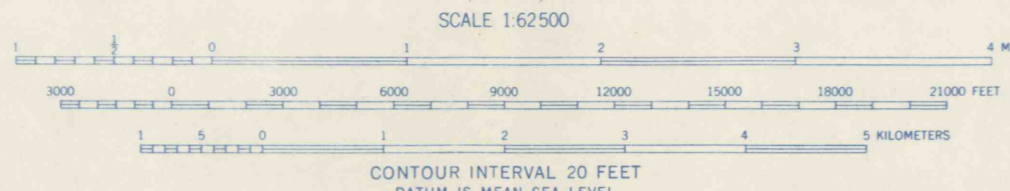

CONTOUR INTERVAL 20 FEET
DATUM IS MEAN SEA LEVEL

INTERIOR - GEOLOGICAL SURVEY, WASHINGTON D. C. - 1913 MR 4639
Polyconic projection, 1927 North American datum

PA
WINDBER
N-400-W78-6/15

FOR SALE BY U. S. GEOLOGICAL SURVEY, WASHINGTON 25, D. C.
A FOLDER DESCRIBING TOPOGRAPHIC MAPS AND SYMBOLS IS AVAILABLE ON REQUEST