

FIELD COPY

UNITED STATES
DEPARTMENT OF THE INTERIOR
GEOLOGICAL SURVEY

VALLEY COAL COMPANY
R.D.#2, Box 250, Mars, Pa.

E. J. Weibel R.S. Aug-16-1966


STATE OF PENNSYLVANIA
REPRESENTED BY THE
DEPARTMENT OF INTERNAL AFFAIRS
TOPOGRAPHIC AND GEOLOGIC SURVEY
(Freeport)

BRADYS BEND TOWNSHIP
ARMSTRONG COUNTY
PERMIT NUMBER-68-1
"C"-OR MIDDLE KITTANNING SEAM

PENNSYLVANIA
KITTANNING QUADRANGLE



H.M. Wilson, Geographer in charge.
Control by S.S. Gannett and E.L. Mc Nair.
Topography by W.L. Miller and W. Carvel Hall.
Surveyed in 1900 in cooperation with the
State of Pennsylvania.

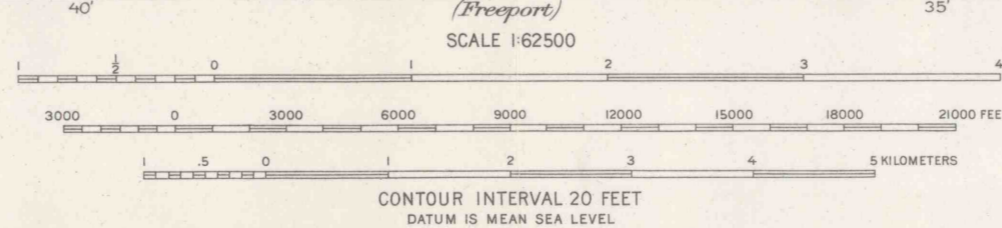

Edition of Jan. 1902, reprinted 1951
Polyconic projection, North American datum

PA
KITTANNING
N 4045- W 7930/15

FOR SALE BY U. S. GEOLOGICAL SURVEY, WASHINGTON 25, D. C.
A FOLDER DESCRIBING TOPOGRAPHIC MAPS AND SYMBOLS IS AVAILABLE ON REQUEST