




H. M. Wilson, Geographer in charge.
Triangulation by A. H. Thompson.
Topography by Frank Sutton, E. B. Clark and J. H. Wheat.

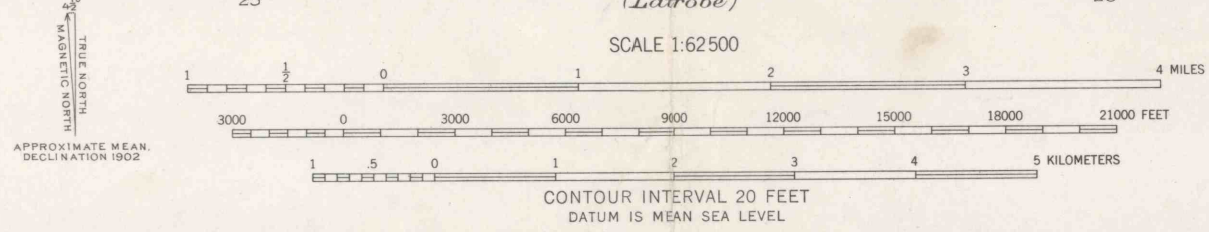

FOR SALE BY U. S. GEOLOGICAL SURVEY, WASHINGTON 25, D. C.
A FOLDER DESCRIBING TOPOGRAPHIC MAPS AND SYMBOLS IS AVAILABLE ON REQUEST

PEN-OH-WES-MAP COMPANY
PHONE 261-0646 611 MABEE BLDG.
936 FOURTH AVE. - PGM., PA. 15222

ELDERS RIDGE, PA.
N4030-W7915/15
1902

Walter E. Bloch
Graff Engineering Co
Blairsville, Pa.
May 25, 1966

C & C Coal Co
R. D. 1 Clarksburg, Pa.

YOUNG TOWNSHIP
INDIANA COUNTY
PERMIT NUMBER 24-1
"D"-OR LOWER FREEPORT SEAM

C & C Mine # 1