

**CARBON TOWNSHIP
HUNTINGDON COUNTY
PERMIT NUMBER - 206-1
A-PRIME-OR CLARION SEAM
(FULTON)**


UNITED STATES
DEPARTMENT OF THE INTERIOR
GEOLOGICAL SURVEY

STATE OF PENNSYLVANIA
REPRESENTED BY THE
DEPARTMENT OF INTERNAL AFFAIRS
TOPOGRAPHIC AND GEOLOGIC SURVEY
(Huntingdon)

PENNSYLVANIA
BROAD TOP QUADRANGLE
1:1920 000 FEET



Topography by C.W. Goodlove, J.K. Bailey,
R.F. Hamke, and W.A. Fisher.
Control by U.S. Geological Survey and
Pennsylvania State Highway Department
Surveyed in 1929-30

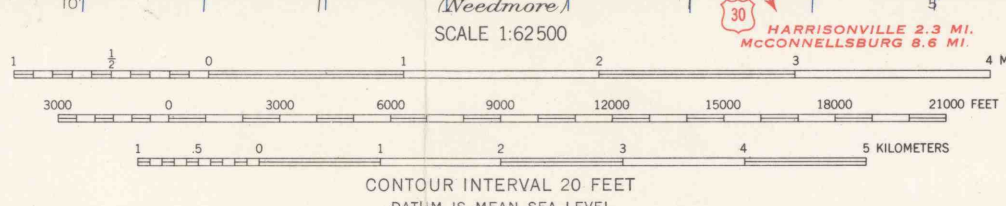

HARRISONVILLE 1 MI.
NEEDMORE 13.8 MI.
HARRISONVILLE 2.3 MI.
MCCONNELLSBURG 8.6 MI.
HARRISONVILLE 5.2 MI.
MCCONNELLSBURG 5.2 MI.
HARRISONVILLE 2.4 MI.

BROAD TOP, PA.
N 4000-W 7800/15

FOR SALE BY U.S. GEOLOGICAL SURVEY, WASHINGTON 25, D. C.
A FOLDER DESCRIBING TOPOGRAPHIC MAPS AND SYMBOLS IS AVAILABLE ON REQUEST

*ACE Coal Co. Chamberland No 3
Carbon Twp. Huntingdon County Penna.
Oct. 1966. E. Corrie*

POTTS DRUG STORE
1100 N. 3rd ST. HARRISBURG, PA.
AGENCY FOR U.S.
GEOLOGICAL SURVEY MAPS