




Topography by J. J. Gayetty, R. C. Seitz, F. H. Sargent,
Frank Lerner, and G. A. Mook
Surveyed in 1927-1928

ROAD CLASSIFICATION
Heavy-duty ——— Light-duty ———
Medium-duty ——— Unimproved dirt ———
○ State Route

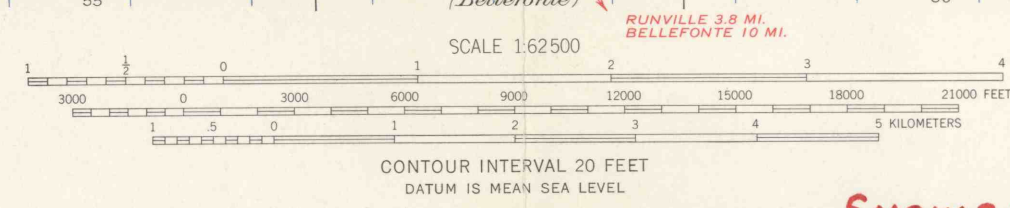

Polyconic projection, 1927 North American datum
10,000-foot grid based on Pennsylvania (North)
rectangular coordinate system
1000-meter Universal Transverse Mercator grid ticks,
zone 18, shown in blue

SNOW SHOE, PA.
N 4100—W 7745/15
1928

FOR SALE BY U. S. GEOLOGICAL SURVEY, WASHINGTON 25, D. C.
A FOLDER DESCRIBING TOPOGRAPHIC MAPS AND SYMBOLS IS AVAILABLE ON REQUEST

**SNOWSHOE & BOGGS TOWNSHIPS
CENTRE COUNTY
PERMIT NUMBER - 126-1
"A"-OR BROOKVILLE SEAM**