


FIELD COPY

SEPT 5 1966
BUREAU OF MINE SUBSIDENCE - PENNA. DEPT. OF MINES

DELL COAL CO
SEPT. 5, 1966
Sewell G. Oldham R.S. 6184

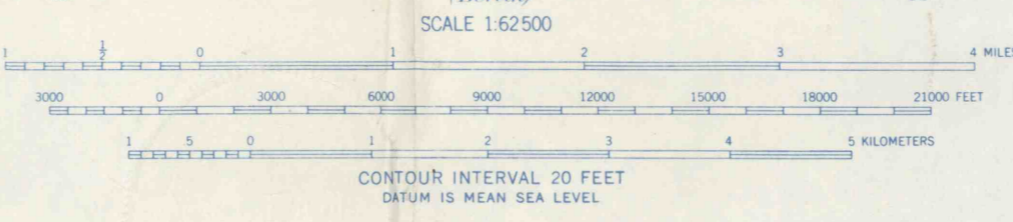

FOR SALE BY U.S. GEOLOGICAL SURVEY, WASHINGTON 25, D. C.
A FOLDER DESCRIBING TOPOGRAPHIC MAPS AND SYMBOLS IS AVAILABLE ON REQUEST

POLYCONIC PROJECTION, 1927 NORTH AMERICAN DATUM
PORTAL-WINDBOROUGH
SOMERSET COUNTY
MINING-RICHLAND TOWNSHIP
CAMBRIA COUNTY
PERMIT NUMBER - 55-1
C-PRIME-OR UPPER KITTANNING SEAM