




H.M. Wilson, Geographer,
Frank Sutton and R.D. Cummin, in charge of section.
Topography by R.D. Cummin and A.C. Roberts, Assistant, B.B. Alexander,
Control by S.S. Gannett and H.B. Paige.
Surveyed in 1901-1904.

EAST WINDBER COAL CO.
NO 5 MINE
LLOYD W. HUFMAN RS. # 2417
AUG. 15, 1966

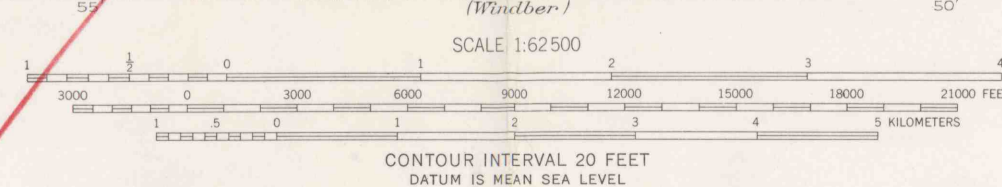

FOR SALE BY U.S. GEOLOGICAL SURVEY, WASHINGTON 25, D. C.
A FOLDER DESCRIBING TOPOGRAPHIC MAPS AND SYMBOLS IS AVAILABLE ON REQUEST

CONEMAUGH TOWNSHIP
SOMERSET COUNTY
PERMIT NUMBER - 29-1
"B"-OR LOWER KITTANNING SEAM

JOHNSTOWN, PA.
N4015-W7845/15

1904