


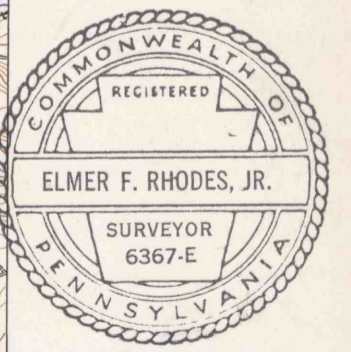


FOG HOLLOW COAL MINE
OPERATOR:
ROBERT M. SHOFF

LOCATED BY:
Elmer F. Rhodes, Jr.
R. S.

October 30, 1966



R.B. Marshall, Chief Geographer.
Frank Sutton, Geographer in charge.
Topography by Robert Muldrow, T.F. Slaughter, and F.W. Farnsworth.
Control by Geo. T. Hawkins, L.F. Biggs, and T.A. Green.
Surveyed in 1912-1913.

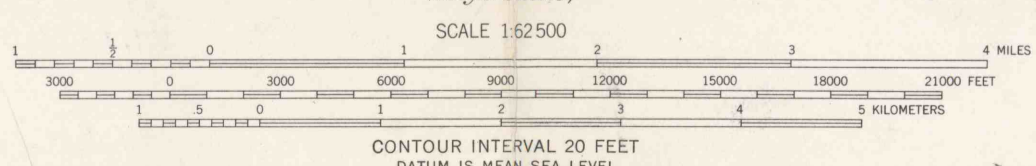

Polyconic projection, 1927 North American datum
PERMIT NUMBER - 215-1
SOMERSET TOWNSHIP
SOMERSET COUNTY
1913
FIELD COPY
"D" - OR LOWER FREEPORT SEAM

FOR SALE BY U. S. GEOLOGICAL SURVEY, WASHINGTON 25, D. C.
A FOLDER DESCRIBING TOPOGRAPHIC MAPS AND SYMBOLS IS AVAILABLE ON REQUEST