




FOGLE-WOULLARD
BLACK TOWNSHIP
SOMERSET COUNTY
PERMIT NUMBER-141-1
"A"-OR BROOKVILLE SEAM

FOGLE COAL CO. - A-SEAM
ELY & FRENCH Oct. 10, 1966

Mapped by the Army Map Service and the Geological Survey
Published for civil use by the Geological Survey
Control by USGS
Topography by plane-table surveys by USGS, 1919
Planimetry revised by AMS from aerial photographs taken 1939
Polyconic projection, 1927 North American datum
10,000-foot grid based on Pennsylvania coordinate system,
south zone
1000-meter Universal Transverse Mercator grid ticks,
zone 17, shown in blue

TRUE NORTH
MAGNETIC NORTH
APPROXIMATE MEAN
DECLINATION, 1939

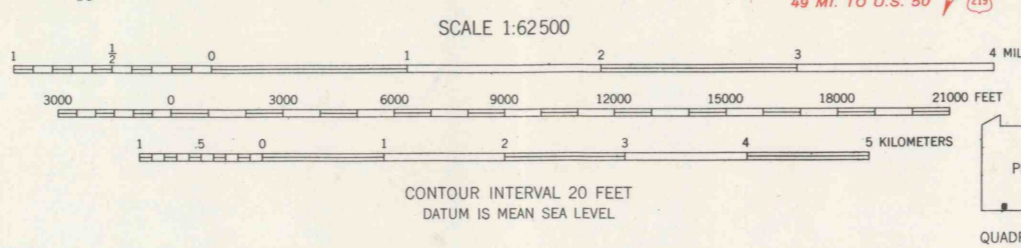

ROAD CLASSIFICATION
Heavy-duty ——— Light-duty ———
Medium-duty ——— Unimproved dirt - - - - -
U.S. Route ——— State Route ———

MEYERSDALE, PA.
N3945-W7900/15
1939

FOR SALE BY U.S. GEOLOGICAL SURVEY, WASHINGTON 25, D. C.
A FOLDER DESCRIBING TOPOGRAPHIC MAPS AND SYMBOLS IS AVAILABLE ON REQUEST