

**JENNER TOWNSHIP  
SOMERSET COUNTY  
PERMIT NUMBER - 316-1  
"PITTSBURGH SEAM"**


UNITED STATES  
DEPARTMENT OF THE INTERIOR  
GEOLOGICAL SURVEY

STATE OF PENNSYLVANIA  
REPRESENTED BY THE  
DEPARTMENT OF INTERNAL AFFAIRS  
TOPOGRAPHIC AND GEOLOGIC SURVEY  
(New Florence)


PENNSYLVANIA  
SOMERSET QUADRANGLE



OPERATOR:  
Dean J. Gindlesperger  
**GINDLESPERGER MINE**  
Located:  
March 1, 1967  
By:  
Elmer F. Rhodes, Jr.  
R. S.

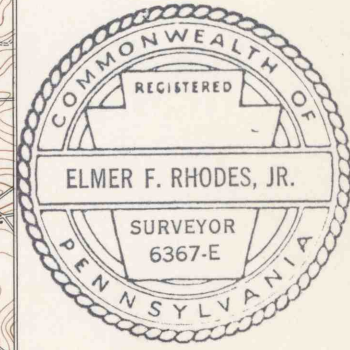

R.B. Marshall, Chief Geographer.  
Frank Sutton, Geographer in charge.  
Topography by Robert Muldrow, T.F. Slaughter, and F.W. Farnsworth.  
Control by Geo. T. Hawkins, L.F. Biggs, and T.A. Green.  
Surveyed in 1912-1913.

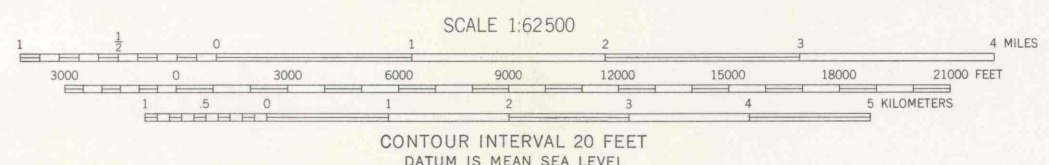

Polyconic projection. 1927 North American datum  
APPROXIMATE MEAN DECLINATION 1913.

SOMERSET, PA.  
N 4000-W 7900/15  
1913

FOR SALE BY U. S. GEOLOGICAL SURVEY, WASHINGTON 25, D. C.  
A FOLDER DESCRIBING TOPOGRAPHIC MAPS AND SYMBOLS IS AVAILABLE ON REQUEST