





**SOUTH BEND TOWNSHIP  
ARMSTRONG COUNTY  
PERMIT NUMBER - 4-1  
"E"-OR UPPER FREEPORT SEAM**

Walter E. Bloch  
Graff Engineering Co.  
Blairsville, Pa

Partner Coal Co.  
R.D. Apollo, Pa.

H.M. Wilson, Geographer in charge.  
Triangulation by A.H. Thompson.  
Topography by Frank Sutton, E.B. Clark and J.H. Wheat.

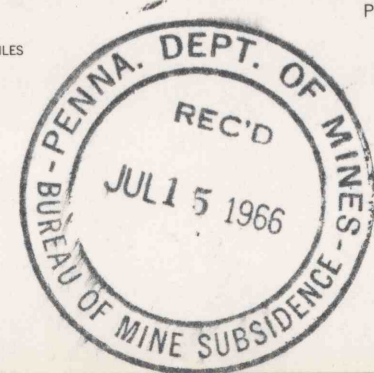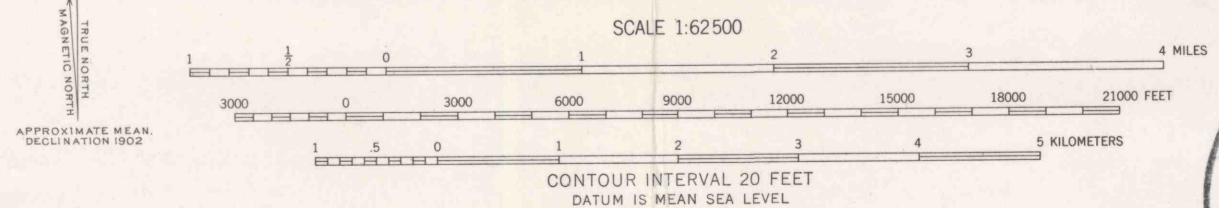

ELDERS RIDGE, PA.  
N4030-7915/15  
1902