




Patsy Corvi Coal
Patsy Corvi Coal Co
Hill Mine
E. 500M. of Coal.
located by
M.E. TREMEL
ENGR. Reg. No
13535
UPPER FREEPORT
WESTMORELAND CO. PA.
FAIRFIELD TWP.

C.H. Birdseye, Chief Topographic Engineer.
Frank Sutton, Topographic Engineer in charge.
Topography by C.C. Gardner, J.L. Lewis, and M.J. Gleissner.
Control by Geo. T. Hawkins, S.S. Gannett, Sledge Tatum,
E.L. McNair, S.L. Parker, Walter McCrea, and
Pennsylvania State Highway Department.
Surveyed in 1920.
LIGNONIER 1 MI.
DONSAL (JUNC. U.S. 30) 1.8 MI.
SURVEYED IN COOPERATION WITH THE STATE OF PENNSYLVANIA.

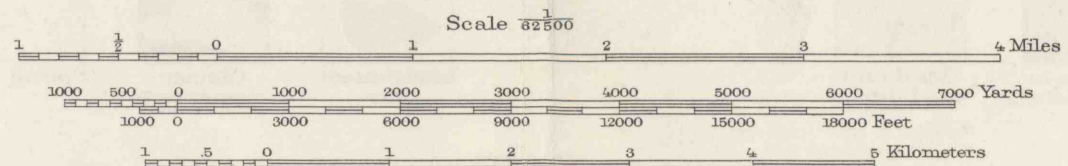

Polyconic projection, North American datum.
5000 yard grid based upon U.S. zone system, B.

NEW FLORENCE, PA.
Edition of 1922,
reprinted 1943
N4015-W7900/15

ROAD CLASSIFICATION
HARD-SURFACE ALL WEATHER ROADS
Heavy-duty ———— 4 LANE LANE Improved dirt
Medium-duty ———— 2 LANE LANE Unimproved dirt
Loose-surface, graded, or narrow hard-surface - - - -
U. S. Route State Route

FAIRFIELD TOWNSHIP
WESTMORELAND COUNTY
PERMIT NUMBER - 208-1
"E"-OR UPPER FREEPORT SEAM