




KELLY MINE  
KENNETH A.  
SHAW COAL  
COMPANY  
DECEMBER 30,  
1966  
SUBSIDENCE  
AREA  
LOCATED BY  
JOHN C. PASSAGE  
R.S.

H.M. Wilson, Geographer,  
Frank Sutton and R.D. Cummin, in charge of section.  
Topography by R.D. Cummin and A.C. Roberts, Assistant, B.B. Alexander,  
Control by S.S. Gannett and H.B. Paige.  
Surveyed in 1901-1904.

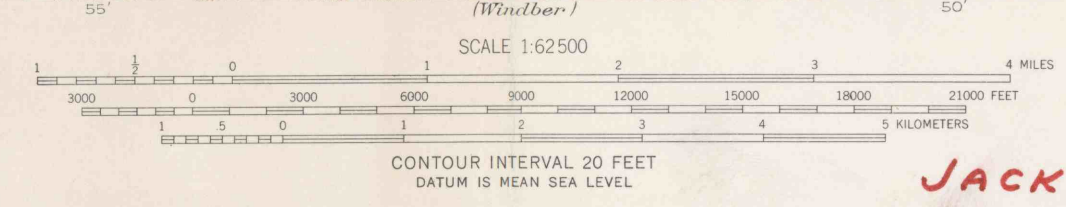

**JACKSON TOWNSHIP  
CAMBRIA COUNTY  
PERMIT NUMBER - 249-1  
"B"-OR LOWER KITTANNING SEAM**

JOHNSTOWN, PA.  
N4015-W7845/5  
1904

FOR SALE BY U.S. GEOLOGICAL SURVEY, WASHINGTON 25, D. C.  
A FOLDER DESCRIBING TOPOGRAPHIC MAPS AND SYMBOLS IS AVAILABLE ON REQUEST

FIELD COPY

SEAL