

FREEDOM MINING CO., INC.
MILTON No. 1 MINE
submitted by: J. W. HUBBARD

UNITED STATES
DEPARTMENT OF THE INTERIOR
GEOLOGICAL SURVEY

STATE OF PENNSYLVANIA
REPRESENTED BY THE
DEPARTMENT OF INTERNAL AFFAIRS
TOPOGRAPHIC AND GEOLOGIC SURVEY
(Brookville)

PORTER TOWNSHIP
JEFFERSON COUNTY
PERMIT NUMBER - 322-2
"B" OR LOWER KITTANNING SEAM


PENNSYLVANIA
SMICKSBURG QUADRANGLE

FIELD COPY

6-22-67
J. W. Hubbard



Frank Sutton, Geographer in charge,
Topography by Wm. O. Tufts and R.H. Reineck,
Control by A.H. Thompson, Geo. T. Hawkins, and Robt. D. Cummin,
Surveyed in 1906-1907.
Partial revision in 1938 by D.H. Watson and H.R. Kilmer

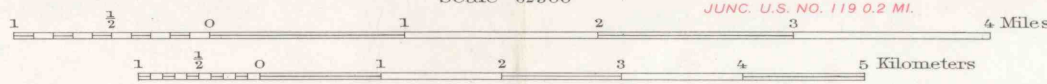

Contour interval 20 feet.
Datum is mean sea level.

ROUTES USUALLY TRAVELED
HARD IMPERVIOUS SURFACES
OTHER SURFACE IMPROVEMENTS
U. S. ROUTE 1943 STATE ROUTE

PA.
SMICKSBURG

FOR SALE BY U. S. GEOLOGICAL SURVEY, WASHINGTON 25, D. C.
A FOLDER DESCRIBING TOPOGRAPHIC MAPS AND SYMBOLS IS AVAILABLE ON REQUEST

N 4045-W7900/15
1938

POTTS DRUG STORE
1100 N. 3rd ST. HARRISBURG, PA.
AGENCY FOR U. S.
GEOLOGICAL SURVEY MAPS