


FIELD COPY

UNITED STATES  
DEPARTMENT OF THE INTERIOR  
GEOLOGICAL SURVEY


STATE OF PENNSYLVANIA  
REPRESENTED BY THE  
DEPARTMENT OF INTERNAL AFFAIRS  
TOPOGRAPHIC AND GEOLOGIC SURVEY  
(Brookville)

PENNSYLVANIA  
SMICKSBURG QUADRANGLE

OWNER  
LEON E. ORF COAL CO.  
L. JON E. ORF  
UPPER FREEPORT  
ORF #6  
MINE-  
DEEP-PROP.  
"NO STRUCTURES  
ON SURFACE."  
12/12/66  
LOCATED BY  
J.M. DICKEY, JR.

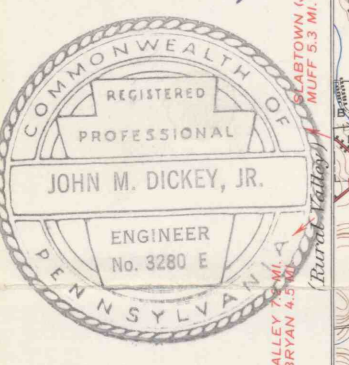

Frank Sutton, Geographer in charge.  
Topography by Wm. O. Tufts and R. H. Reineck.  
Control by A. H. Thompson, Geo. T. Hawkins, and Robt. D. Cummin.  
Surveyed in 1906-1907.  
Partial revision in 1938 by D. H. Watson and H. R. Kilmer.

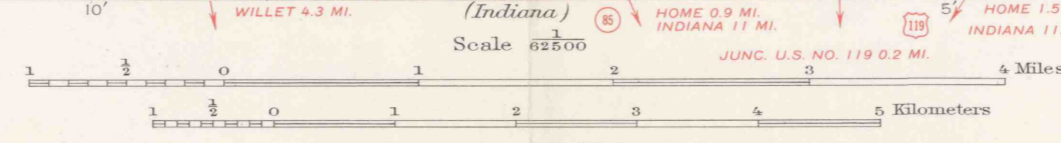

ROUTES USUALLY TRAVELED  
HARD IMPERVIOUS SURFACES  
OTHER SURFACE IMPROVEMENTS  
U. S. ROUTE 1943 STATE ROUTE

PA.  
SMICKSBURG

POTTS DRUG STORE  
1100 N. 3rd ST. HARRISBURG, PA.  
AGENCY FOR U. S.  
GEOLOGICAL SURVEY MAPS

PORTER TOWNSHIP  
JEFFERSON COUNTY  
PERMIT NUMBER - 335-1  
"E"-OR UPPER FREEPORT SEAM

FOR SALE BY U. S. GEOLOGICAL SURVEY, WASHINGTON 25, D. C.  
A FOLDER DESCRIBING TOPOGRAPHIC MAPS AND SYMBOLS IS AVAILABLE ON REQUEST

N 4045-W7900/15  
1938