


Topography by E. V. Holloway, F. H. Sargent, E. M. Thompson, C. R. Atkins, C. A. Killian, and W. A. Fisher. Surveyed in 1940-1941.


Topography by F. H. Sargent, C. R. Atkins, H. F. Ewing, and C. A. Killian. Surveyed in 1941.


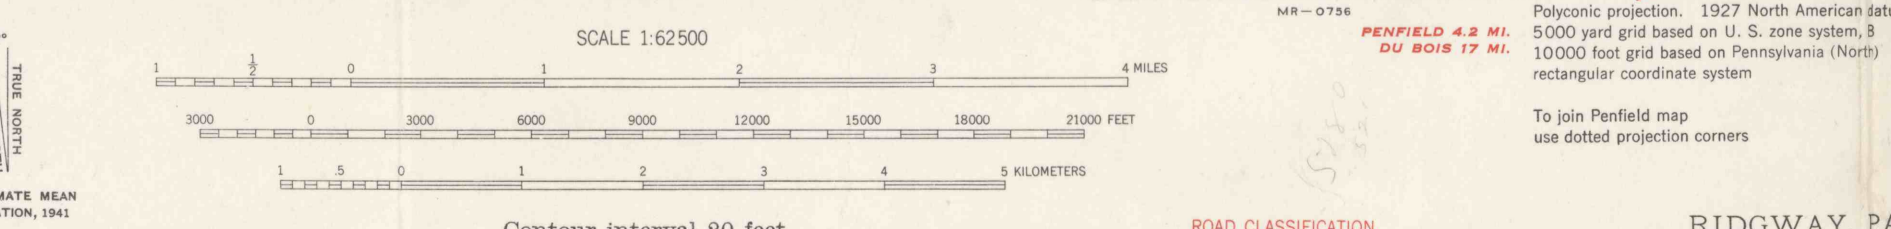

Contour interval 80 feet. Datum is mean sea level. ROAD CLASSIFICATION: Heavy-duty, Medium-duty, Light-duty, U.S. Route, State Route. RIDGWAY, PA. N4115-W7830/5 1941

FOR SALE BY U.S. GEOLOGICAL SURVEY, WASHINGTON 25, D. C. A FOLDER DESCRIBING TOPOGRAPHIC MAPS AND SYMBOLS IS AVAILABLE ON REQUEST

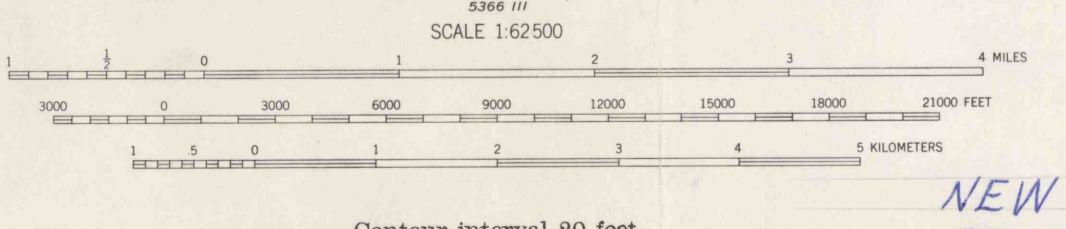

Contour interval 80 feet. Datum is mean sea level. ROAD CLASSIFICATION: Heavy-duty, Medium-duty, Light-duty, U.S. Route, State Route. BENEZETTE, PA. N4115-W7815/15 1941

FOR SALE BY U.S. GEOLOGICAL SURVEY, WASHINGTON, D. C. 20242 A FOLDER DESCRIBING TOPOGRAPHIC MAPS AND SYMBOLS IS AVAILABLE ON REQUEST

NEW SHAWMUT MNG. CO. PROCTOR #4 MINE. PREPARED BY LHBURCH AUG. 20, 1966. JAY TOWNSHIP ELK COUNTY PERMIT NUMBER -180-3 "B" OR LOWER KITTANNER SEAM. AMS 5366 (V)-SERIES V731