



QUEMAHONING TOWNSHIP  
SOMERSET COUNTY  
PERMIT NUMBER - 308-1  
"E" - OR UPPER FREEPORT SEAM

CARR MINING CO. - RALPHTON DEEP MINE  
ELY & FRENCH - MARCH 1, 1917

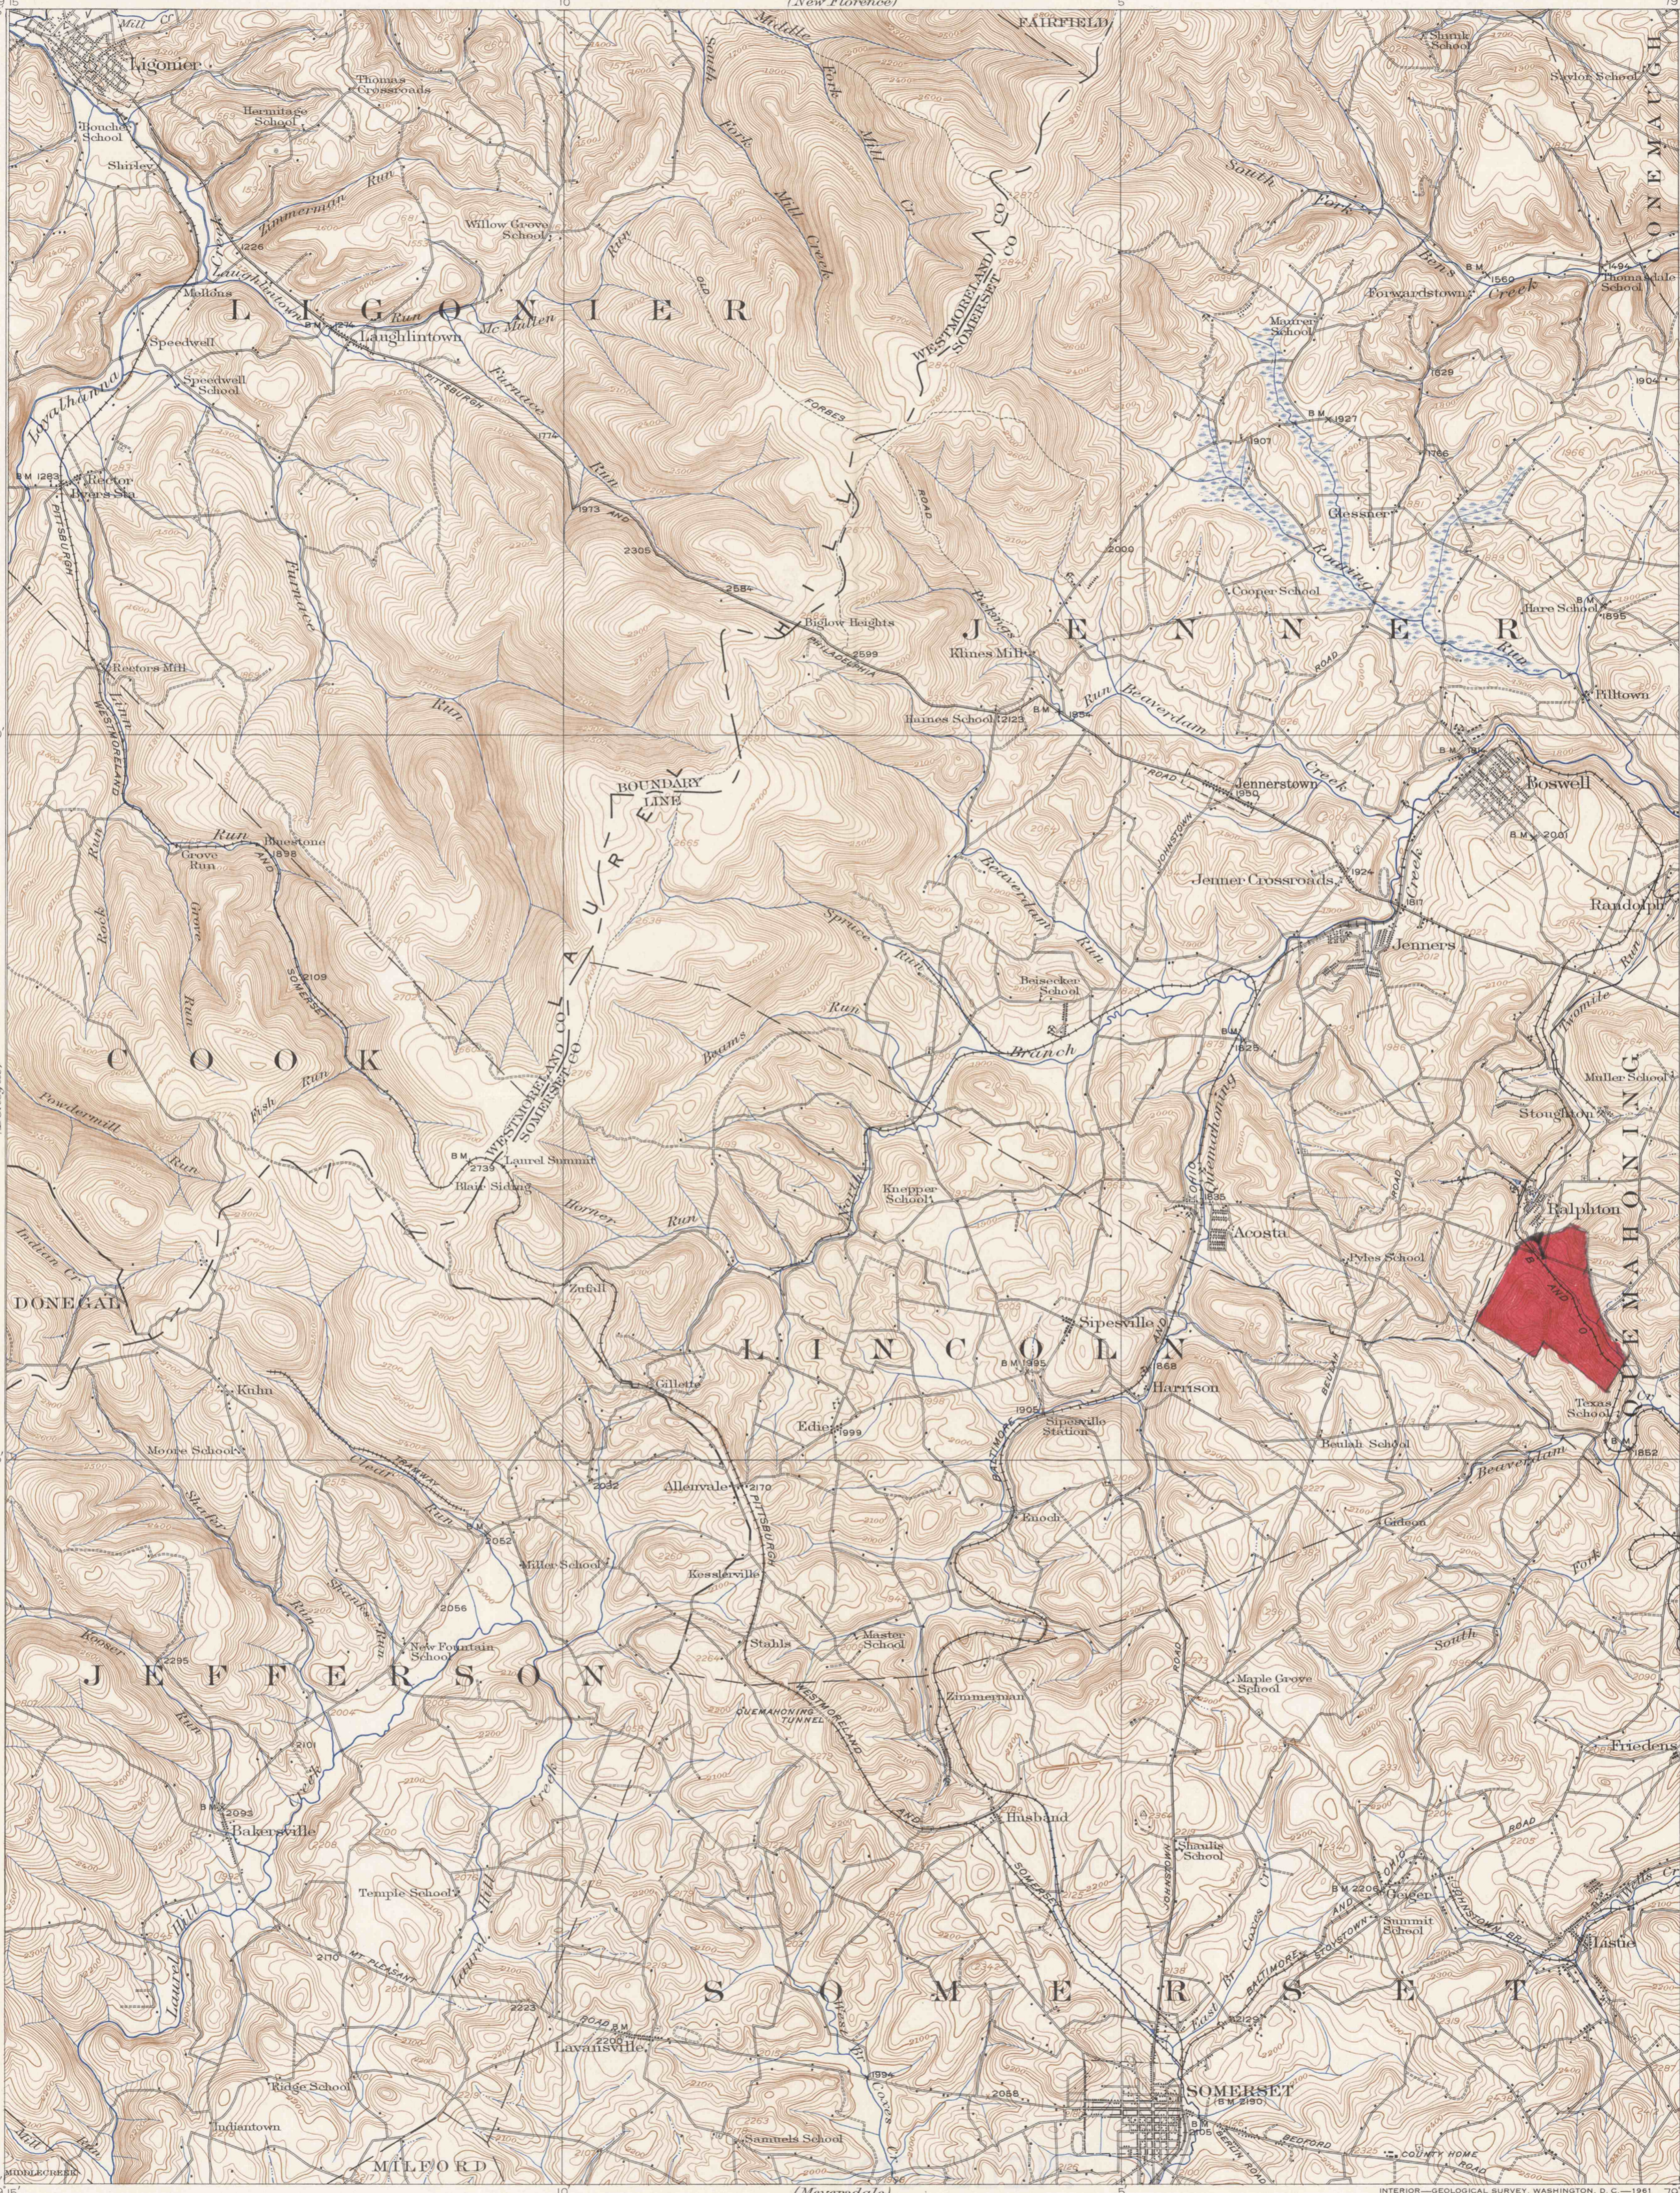

R.B. Marshall, Chief Geographer.  
Frank Sutton, Geographer in charge.  
Topography by Robert Muldrow, T.F. Slaughter, and F.W. Farnsworth.  
Control by Geo. T. Hawkins, L.F. Biggs, and T.A. Green.  
Surveyed in 1912-1913.

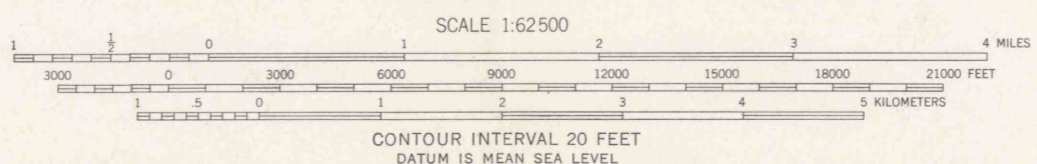

Interior—Geological Survey, Washington, D. C.—1911  
Polyconic projection. 1927 North American datum

SOMERSET, PA.  
N 4000—W 7900/15

1913

FOR SALE BY U. S. GEOLOGICAL SURVEY, WASHINGTON 25, D. C.  
A FOLDER DESCRIBING TOPOGRAPHIC MAPS AND SYMBOLS IS AVAILABLE ON REQUEST