


Mapped by the Army Map Service and the Geological Survey  
Published for civil use by the Geological Survey

Control by USGS  
Topography by plane-table surveys by USGS, 1919  
Planimetry revised by AMS from aerial photographs taken 1939  
Polyconic projection. 1927 North American datum  
10,000-foot grid based on Pennsylvania coordinate system,  
south zone  
1000-meter Universal Transverse Mercator grid ticks,  
zone 17, shown in blue

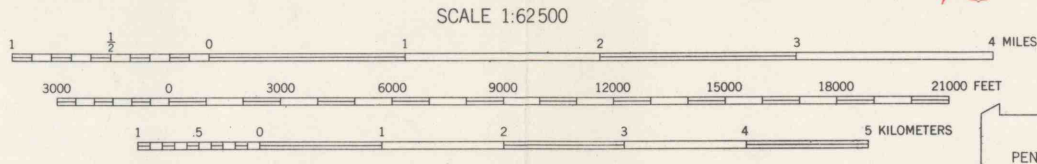

ROAD CLASSIFICATION

Heavy-duty	Light-duty
Medium-duty	Unimproved dirt
U.S. Route	State Route



MEYERSDALE, PA.  
N 3945—W 7900/15  
1939

FOR SALE BY U.S. GEOLOGICAL SURVEY, WASHINGTON 25, D. C.  
A FOLDER DESCRIBING TOPOGRAPHIC MAPS AND SYMBOLS IS AVAILABLE ON REQUEST

Boynnton Coal Co.  
PERMIT NUMBER - 310-1

APPROXIMATE MEAN  
DECLINATION, 1939