


DEEPCOAL MINE
OPERATION OF
SELIGA COAL CO.
C-SEAM UPPER
KITTANNING.
LOCATED BY
M.E. TREMEL
ENGR. REG. NO. 13535
SEPT. 19, 1966.

R. B. Marshall, Chief Geographer,
Frank Sutton, Geographer in charge,
Topography by Robert Muldrow, Oscar Jones,
E. E. Witherspoon, and E. D. Monroe,
Control by Geo. T. Hawkins and T. A. Green,
Surveyed in 1913-1914.

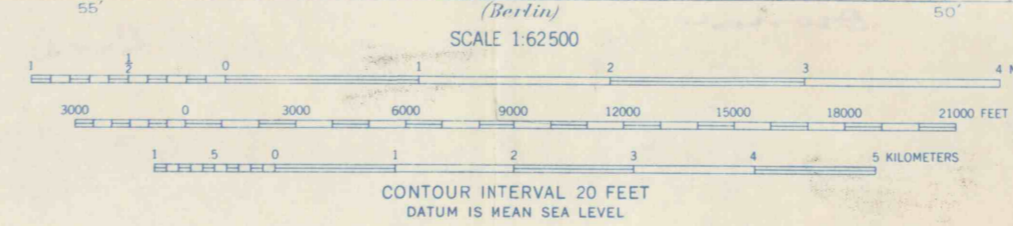

INTERIOR-GEOLOGICAL SURVEY, WASHINGTON, D. C. - 1963 MR 4639
Polyconic projection, 1927 North American datum

PA
WINDBER
N4000-W78-5/15