




FIELD COPY

R.B. Marshall, Chief Geographer.
Frank Sutton, Geographer in charge.
Topography by Robert Muldrow, Oscar Jones,
E.E. Witherspoon, and E.D. Monroe.
Control by Geo. Hawkins and T.A. Green.
Surveyed in 1913-1914.

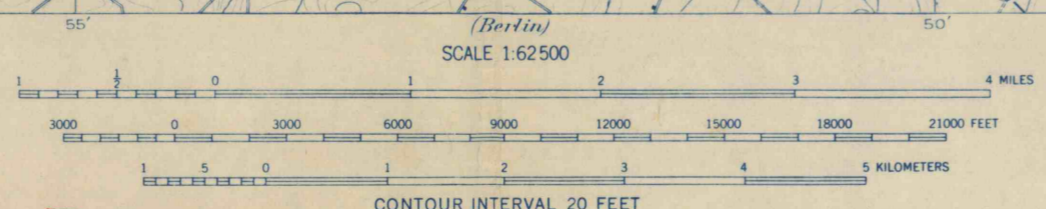

EVERETTS HYDER
MINE #20
SEPT-6-1966 Y. LERICKSON RPE 7074
PERMIT NUMBER - 56-1 - "D" - OR LOWER
FREEPORT SEAM

