



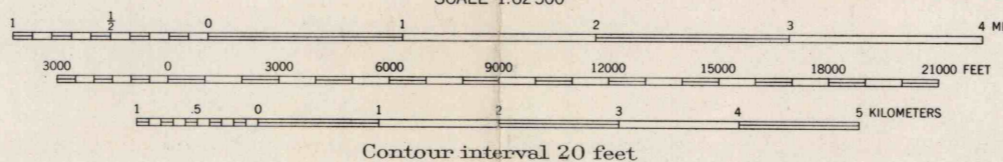

Topography by G.J. Baker, H.F. Ewing, Charles Mager, Jr., and C.H. Parker. Surveyed in 1942-1943.

ARTHUR A. WITTIG
Bituminous Drift Mine
Barclay Twp., Bradford Co.
Prepared by B. Kantz
Wellsboro, Penna.

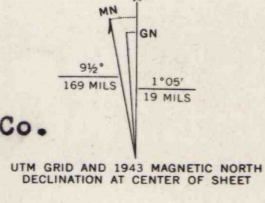

ROAD CLASSIFICATION

Heavy-duty	Light-duty
Medium-duty	Unimproved dirt
U.S. Route	State Route

10000 foot grid based on Pennsylvania (North) rectangular coordinate system
1000-meter Universal Transverse Mercator grid ticks, zone 18, shown in blue

POWELL, PA.
N4330-W7630/15
1943
AMS 5667 II-SERIES V731

PERMIT NUMBER - 325-1
"B"- OR LOWER KITTANNING SEAM

FOR SALE BY U. S. GEOLOGICAL SURVEY, WASHINGTON 25, D. C.
A FOLDER DESCRIBING TOPOGRAPHIC MAPS AND SYMBOLS IS AVAILABLE ON REQUEST

3213 #