


COMMONWEALTH OF PENNSYLVANIA
DEPARTMENT OF ENVIRONMENTAL RESOURCES
BUREAU OF LAND PROTECTION
DIVISION OF MINE SUBSIDENCE REGULATION

MINE MAP
OF
CAMBRIA COUNTY
JANUARY - 1975 JSO

SCALE

MINING COMPLETED AREAS
LOWER KITTANNING or "B" COAL SEAM

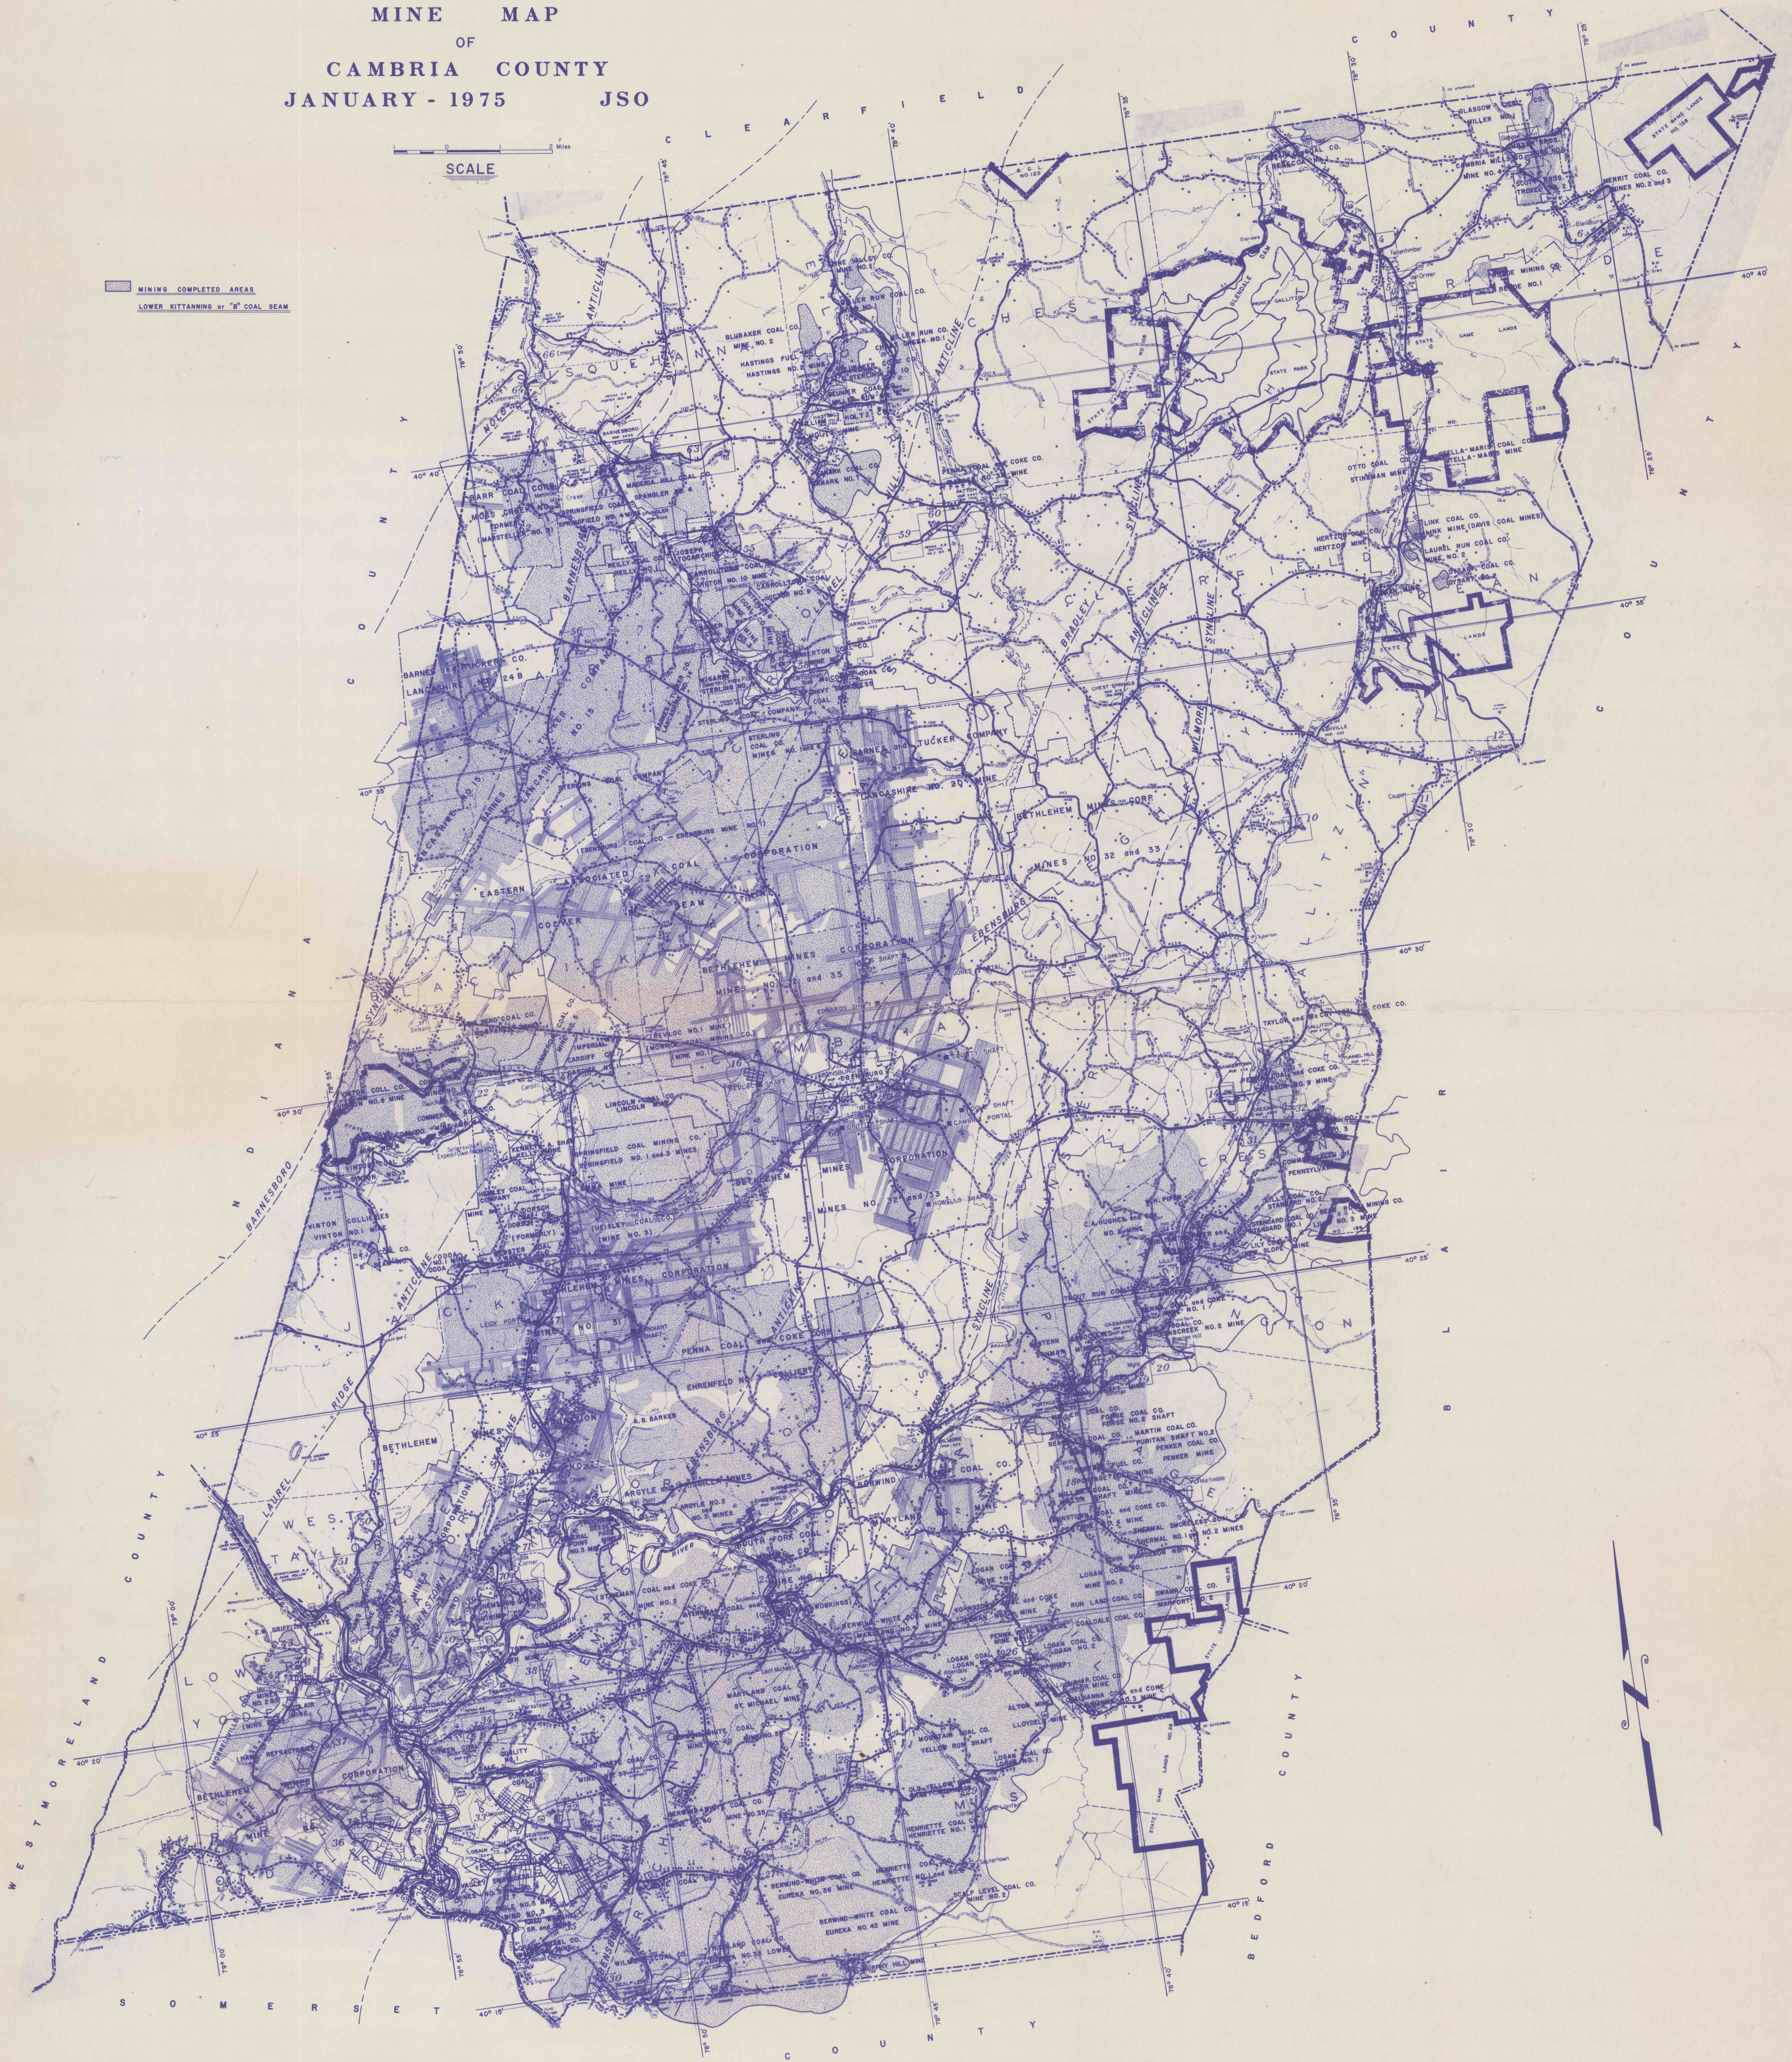

CAMBRIA CO.

CAMBRIA CO.