

INDEX			
NO.	SECT.	NAME OF MINE	TOWNSHIP
1	935	Moradock	Franklin
2	"	Guthrie	"
3	"	Lapping	"
4	"	Taylor	"
5	"	Brick & Stone	"
6	"	Carpenter	"
7	"	Camp Run	"
8	"	Morris	"
9	"	Plant	"
10	"	Sayers #2	"
11	"	" #1	"
12	"	High Rock	"
13	"	Cosgray	"
14	"	Prairie	"
15	"	Downey	"


16	935	Zimmerman	Franklin
17	"	Phillips	"
18	"	Co. Home	"
19	"	Mack C. Co.	"
20	"	Harvey	Morgan
21	932	Kent	"
22	"	Gordon	"
23	"	G. Harr.	"
24	"	C. Harry	"
25	"	Taylor #2	"
26	"	" #2	"
27	"	Craynes	"
28	"	Moore	"
29	"	Bennett	"
30	935	Ankrom	Jefferson
31	"	Willis	"
32	"	Patterson	"
33	"	Phillips	Morgan

34	932	Moreclock	Morgan
35	"	Radman	"
36	933	Stewart	Jefferson
37	"	Bell	"
38	"	Copper Rock	"
39	"	Mather Farm	Morgan
40	"	Mather Coal Co	"
41	"	True	Jefferson
42	"	Rogers #2	"
43	"	" #1	"
44	"	Hupp	Jefferson
45	"	Sharonneck	"
46	"	Malitta	"
47	"	Turner	"
48	"	Morris	Jefferson
49	"	Fallon	"
50	"	Emerald	"
51	"	Turner	Morgan

52	933	Luca	Jefferson
53	"	Dilworth	"
54	"	Bealing	"
55	"	Fuller	"
56	941	Faddis	"
57	"	Price #2	"
58	"	" #1	"
59	"	Shape	Cumberland
60	"	Rochester	"
60 1/2	"	Crucible	"
61	"	J. Fuller	"
62	"	Nycoff	"
63	"	Dody	"
64	"	Patterson	"
65	944	Birch	"
66	941	Guasman #1	"
67	942	Nickleson	"
68	"	McCann	"

69	941	Gideon	Cumberland
70	944	Solomon	"
71	"	Horner	"
72	"	Hathaway	"
73	"	Flenniken	"
74	"	Hathaway	"
75	"	Barclay	"
76	"	Crago	"
77	936	Guasman #2	"
78	936	Craft	"
79	"	J. Ingram	"
80	"	T. Ingram	"
81	"	Stevens	"
82	944	Warne	"
83	"	Nemacolin	"
84	"	McCann	"
85	"	Parker	"
86	"	Stotcheck	"

87	944	Hartley #1	Cumberland
88	"	" #2	"
89	"	Cloud #1	"
90	"	" #2	"
91	"	Reford #1	"
92	"	" #2	"
93	"	Hart	"
94	"	C. Hart	"
95	"	Thomas #2	"
96	"	" #1	"
97	"	Bitasky	"
98	"	Hamilton	"
99	"	Grooms	"
100	"	Hart #2	"
101	"	" #1	"
102	"	Dunham #1	Monongahela
103	"	I. Barclay	"
104	"	Dunham #2	"
105	"	Rich	"
106	"	J. Barclay	"
107	"	Hartley	"
108	"	Durr #2	"
109	"	" #1	"
110	"	Stevenson #1-2-3	"
111	"	J. Keener	Cumberland
112	"	Hartley	"
113	"	Keener	"
114	"	Parker	"
115	947	Alicia #2	Monongahela
116	"	Boiler Ho.	"
117	"	Vance	"
118	"	Barr #1	"
119	"	" #2	"
120	"	Hudik	"
121	"	Donley	Greene
122	"	Martin	"
123	"	Minor	"
124	"	Howard	"
125	939	Ross	"
126	"	Core	"
127	"	U. Blaker	"
128	"	Blaker #2	"
129	"	" #1	"
130	947	Penn Pit	Monongahela
131	"	Dosedale	"
132	"	Poland #3	"
133	"	Mabel #2	"
134	"	Poland #2	"
135	"	Mabel #1	"
136	"	Poland #1	"
137	"	Maple Sterling	Dunkard
138	"	Moffatt	"
139	"	Quertimont	"
140	"	Walnut Hill	"
141	1042	Greene C. Co.	"
142	"	Greene Co.	"
143	"	Morris #2	"
144	947	Gapin #2	"
145	"	Wade	"
146	"	Shanopin	"
147	1041	Hunt	"
148	"	Stevens	"
149	"	Harod	"
150	939	Burrell	"
151	"	Brewer	"
152	"	Garrison	"
153	"	Kenner	"
154	"	Garrison #2	"
155	"	Phillips	"
156	"	Davistown	"

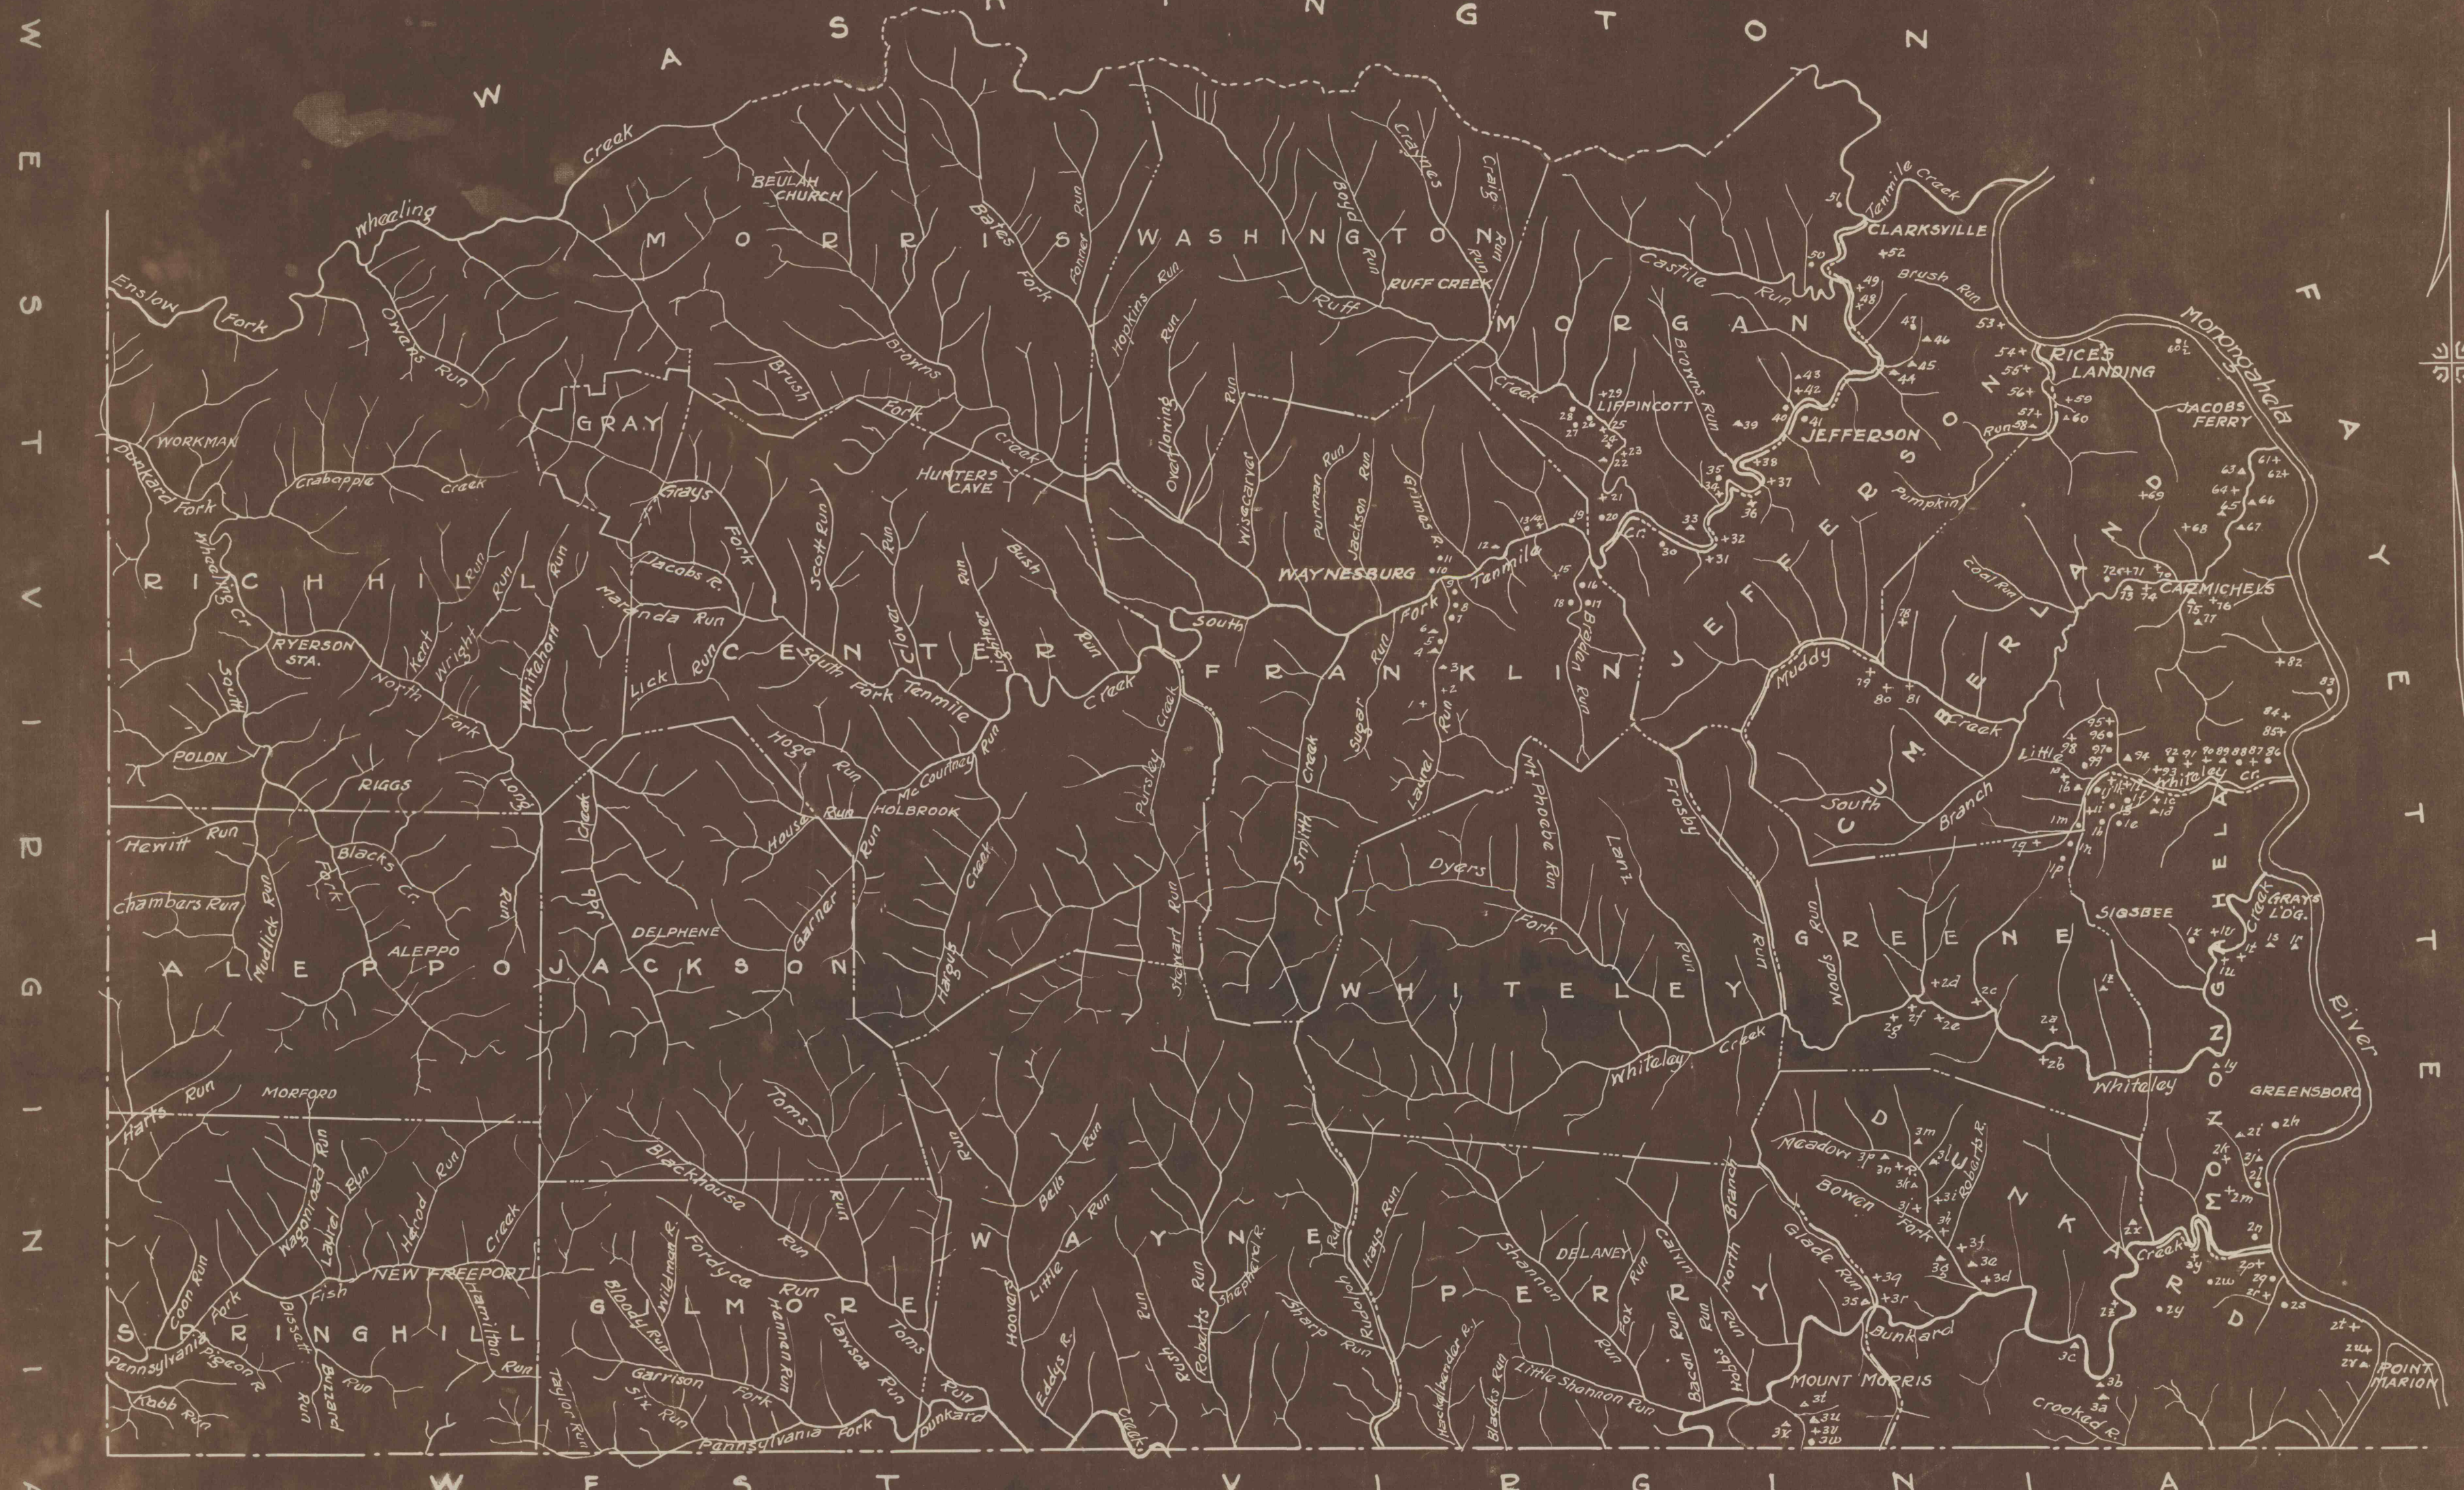

INDEX cont'd			
NO.	SECT.	NAME OF MINE	TOWNSHIP
34	1033	Lemly	Perry
35	"	Gump	"
36	"	Fox #1	"
37	"	Fox #2	"
38	947	Gapin #1	Dunkard
39	"	Williamson	"
40	"	Walfin	"
41	"	Schultz	"
42	"	Stoneking	"
43	"	McCormick	"
44	1033	Clavis	Perry


SEALING ABANDONED COAL MINES  
 PENNSYLVANIA  
 MINE LOCATION MAP OF  
 GREENE COUNTY  
 W.P.A. DIST. NO. 16 - COUNTY NO. 63  
 SCALE 0 1 2 3 MILES  
 JUNE 30, 1937

LEGEND  
 ACTIVE MINE ● ABANDONED MINE +  
 MARGINAL MINE ▲ SEALED MINE ⊕