


The Consolidation Coal Co., Inc.
W.P.A. 8-7.5 & 8-7.6

INTERIOR

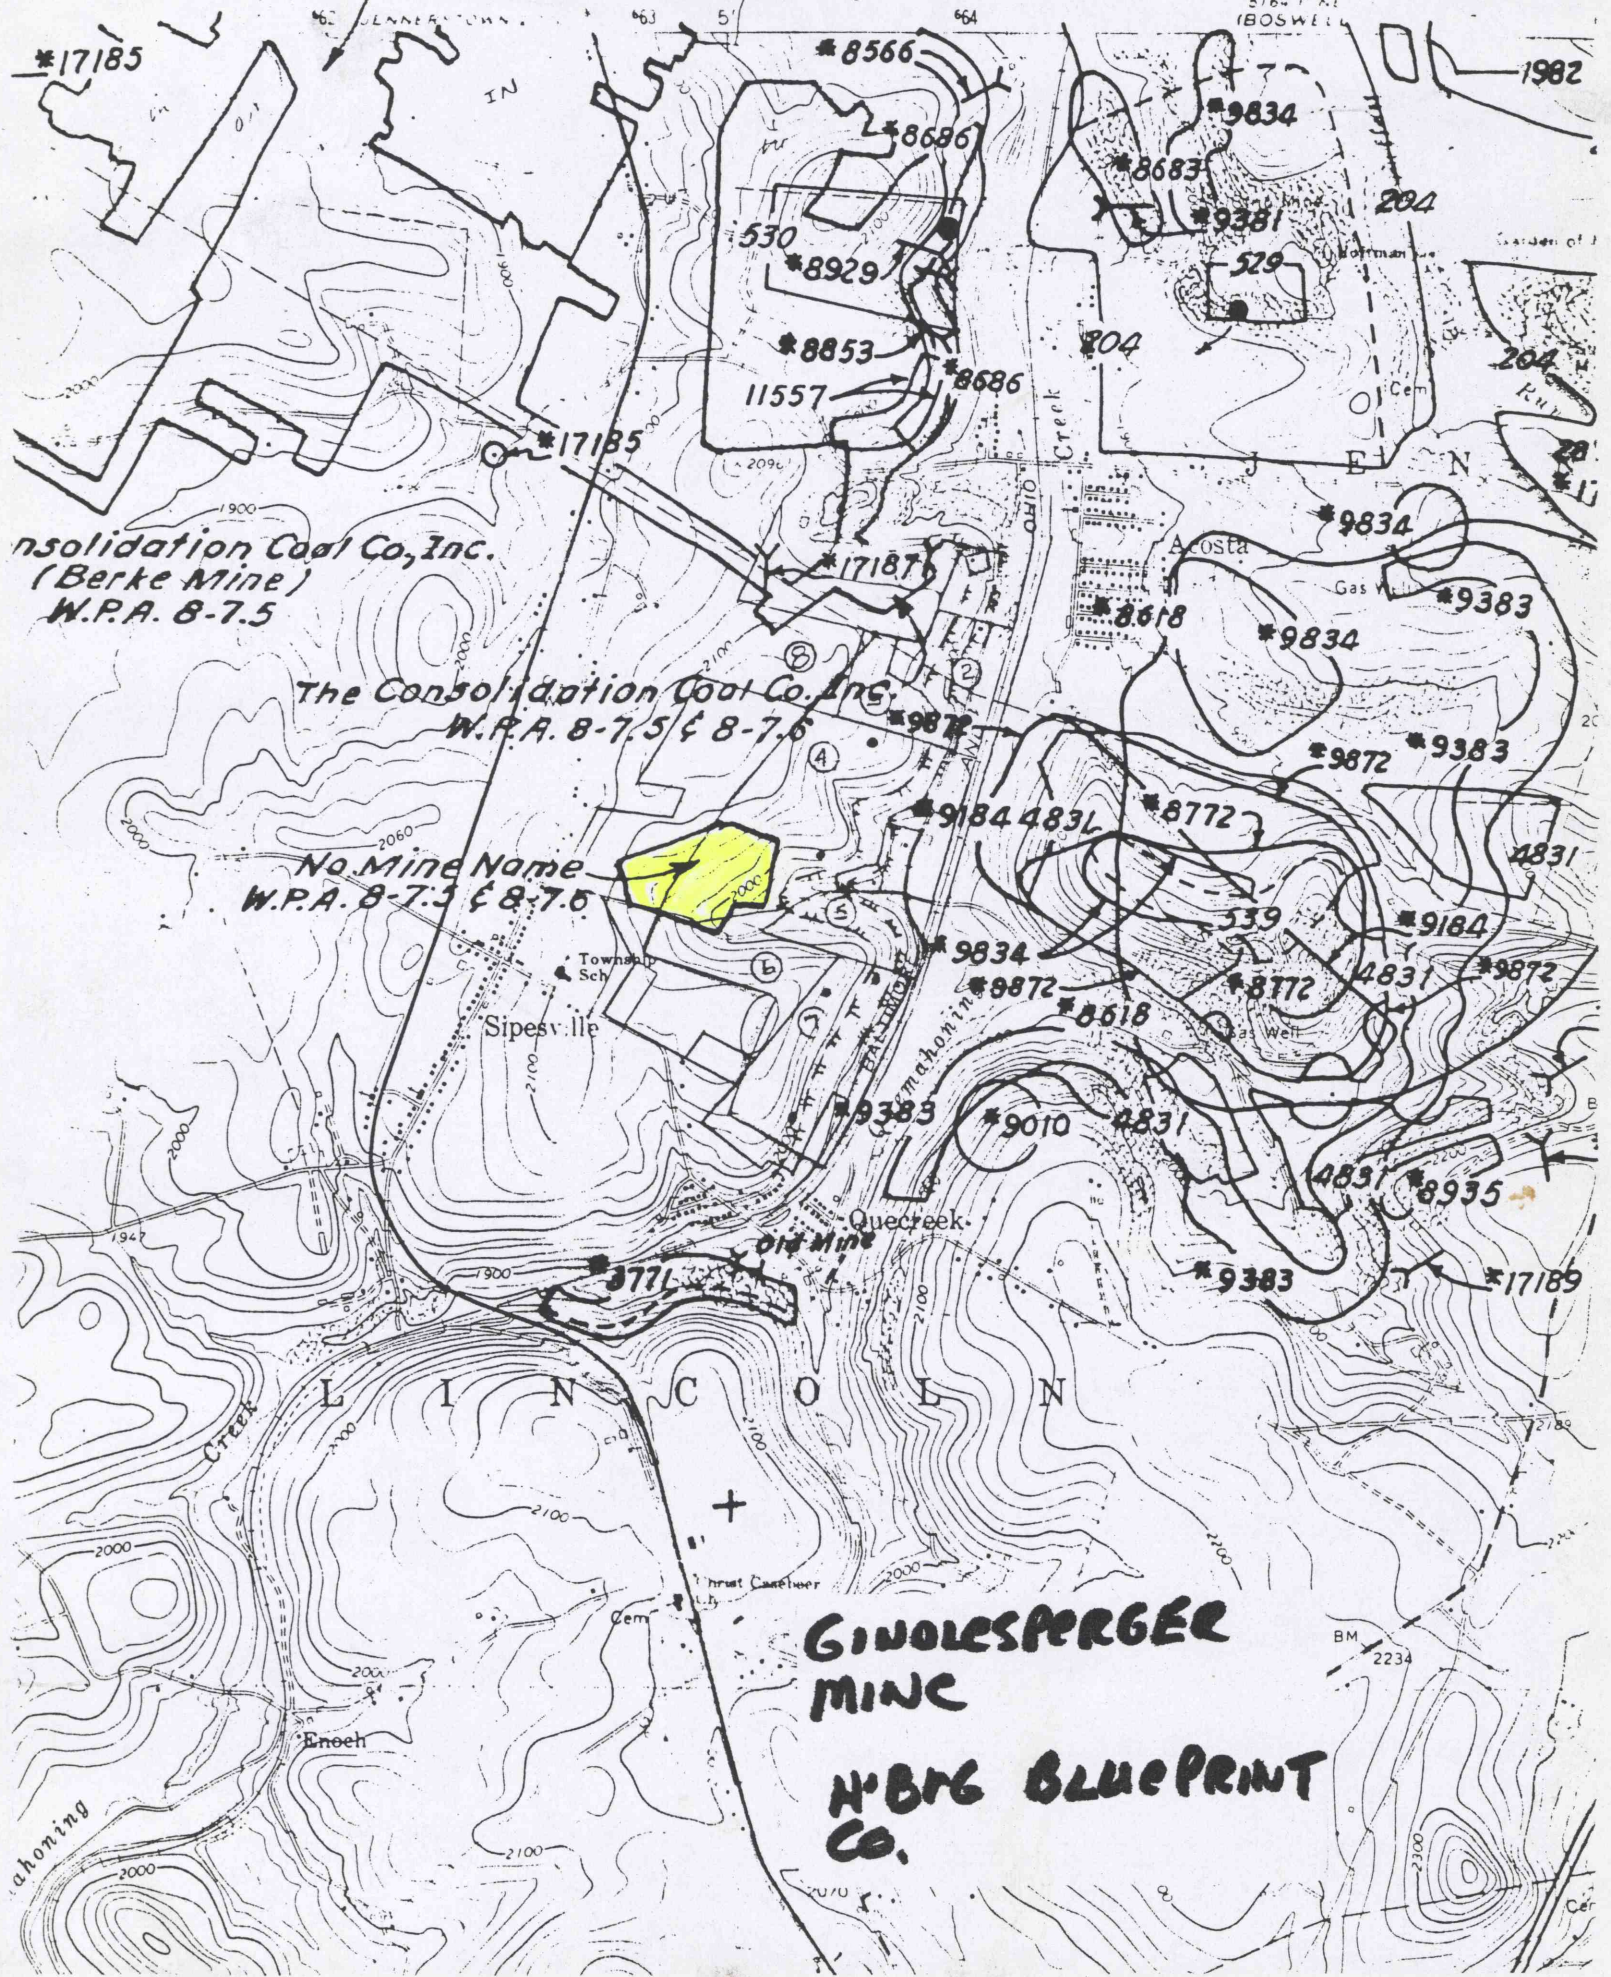

The Consolidation Coal Co., Inc.
(Berke Mine)
W.P.A. 8-7.5

The Consolidation Coal Co., Inc.
W.P.A. 8-7.5 & 8-7.6

No. Mine Name
W.P.A. 8-7.5 & 8-7.6

**GINOLESBERGER
MINE**
**N°BIG BLUEPRINT
CO.**

BM 2234