

LEGEND

- BOUNDARIES OF THE OPERATION
- PORTALS DRILL HOLES
- "D" SEAM OUTCROP
- HOLDING PONDS
- EMERGENCY WATER TREATMENT FACILITIES
- PRESENT DISCHARGE POINT
- PROPOSED EMERGENCY DISCHARGE POINT

U.S.G.S. 7 1/2' Series
STRONGSTOWN Quadrangle

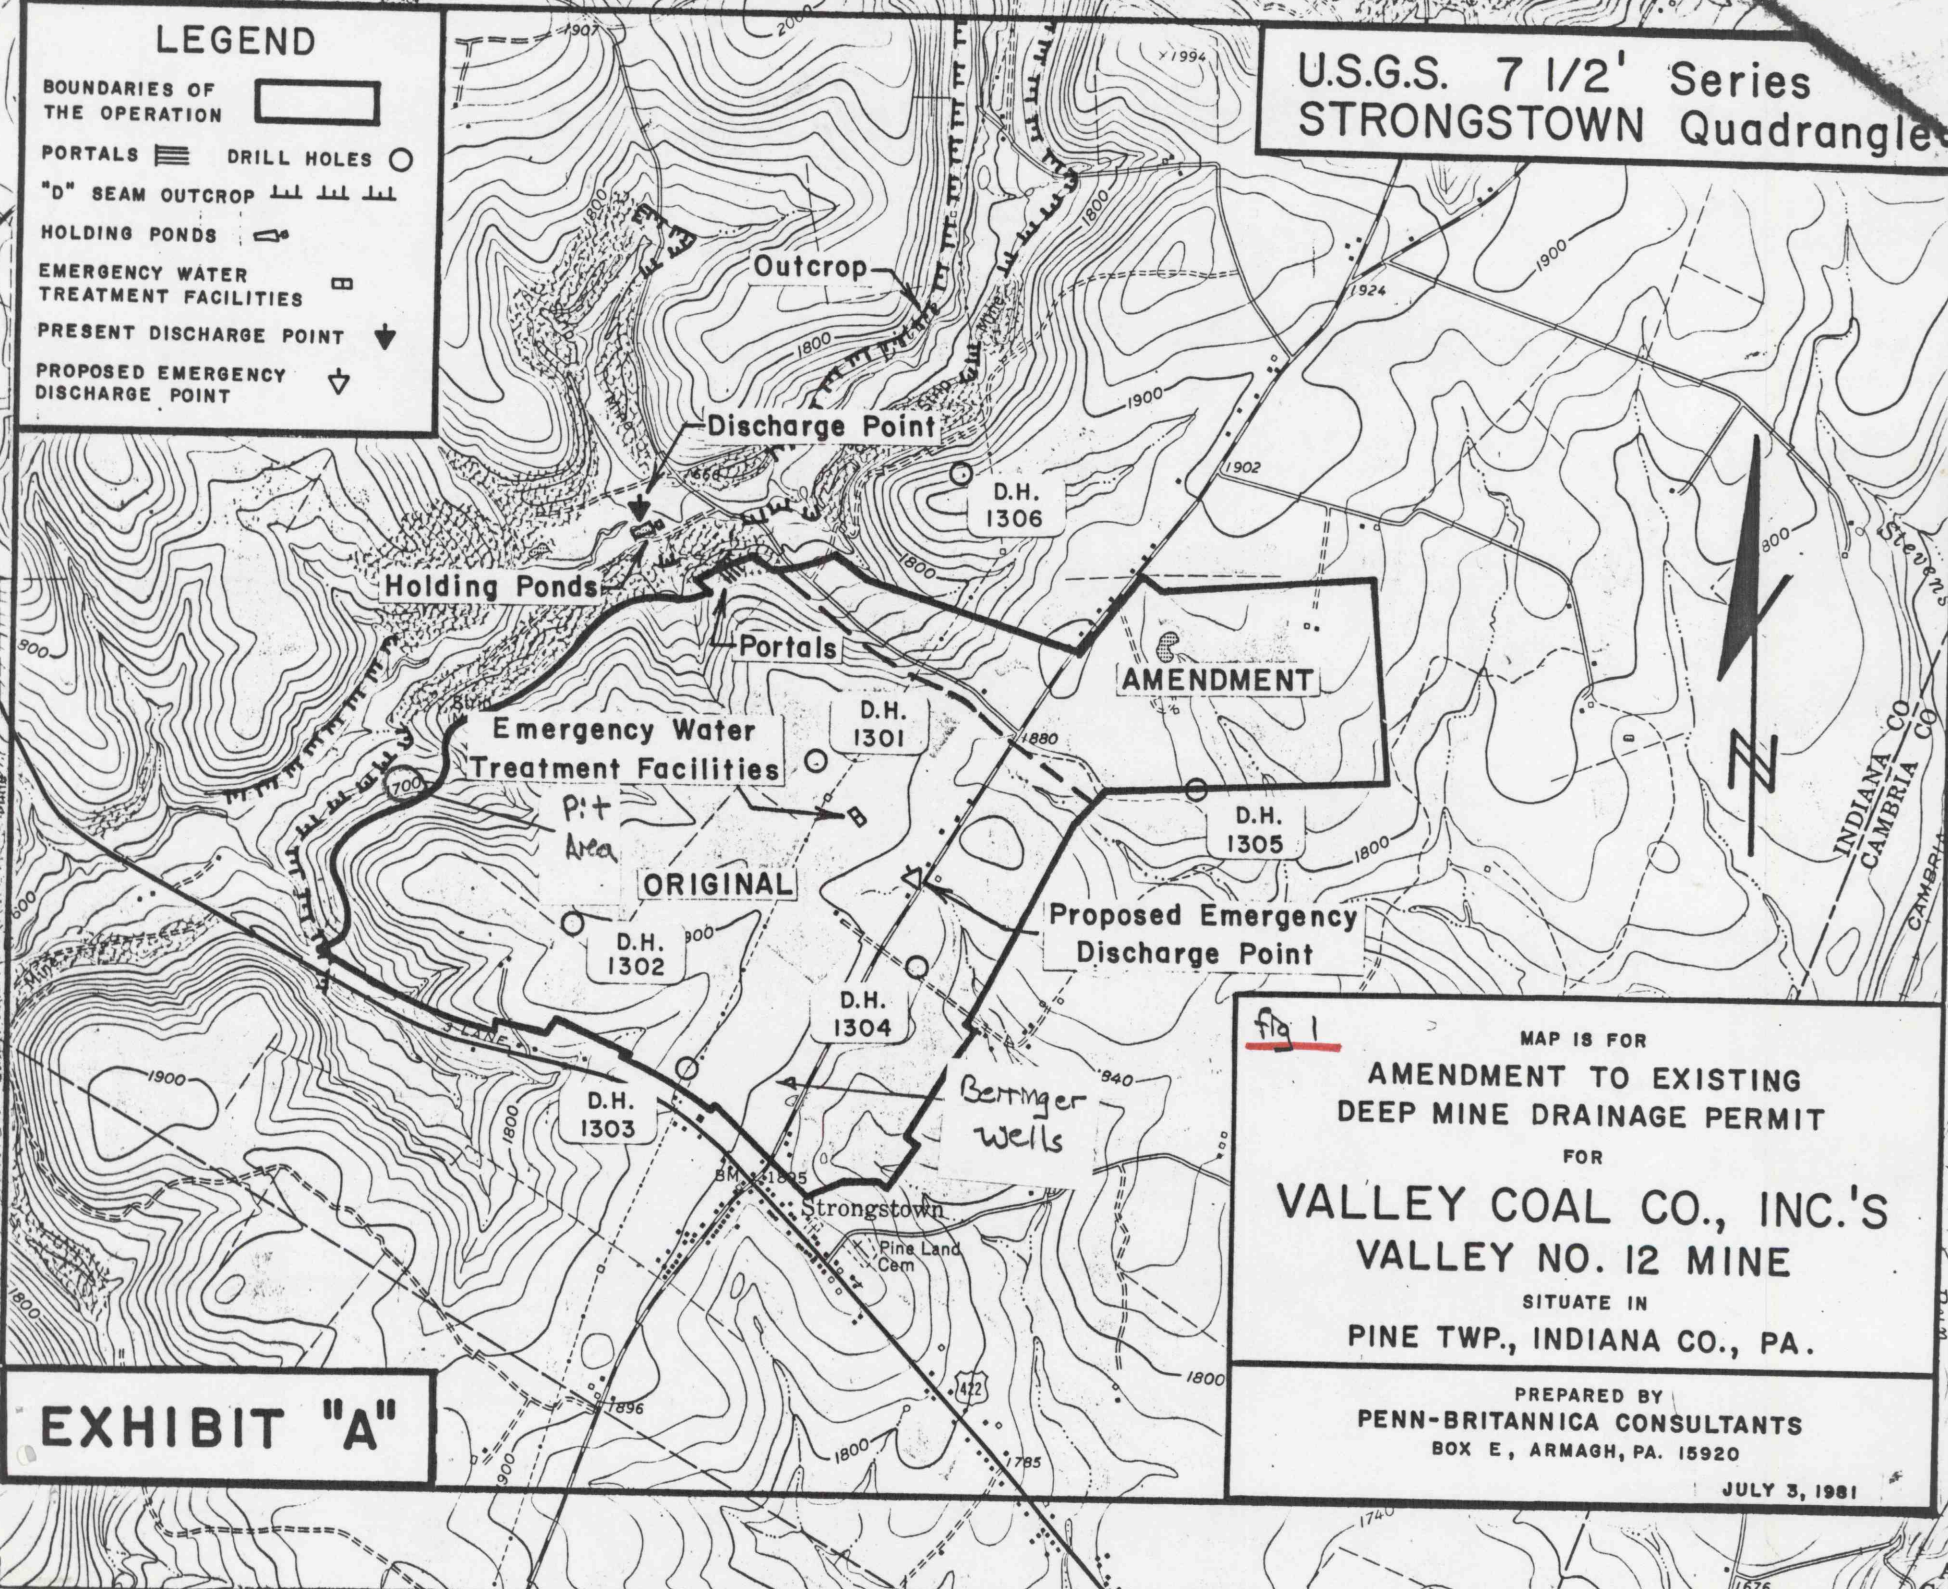


EXHIBIT "A"

fig 1
MAP IS FOR
**AMENDMENT TO EXISTING
DEEP MINE DRAINAGE PERMIT**
FOR
**VALLEY COAL CO., INC.'S
VALLEY NO. 12 MINE**
SITUATE IN
PINE TWP., INDIANA CO., PA.
PREPARED BY
PENN-BRITANNICA CONSULTANTS
BOX E, ARMAGH, PA. 15920
JULY 3, 1981