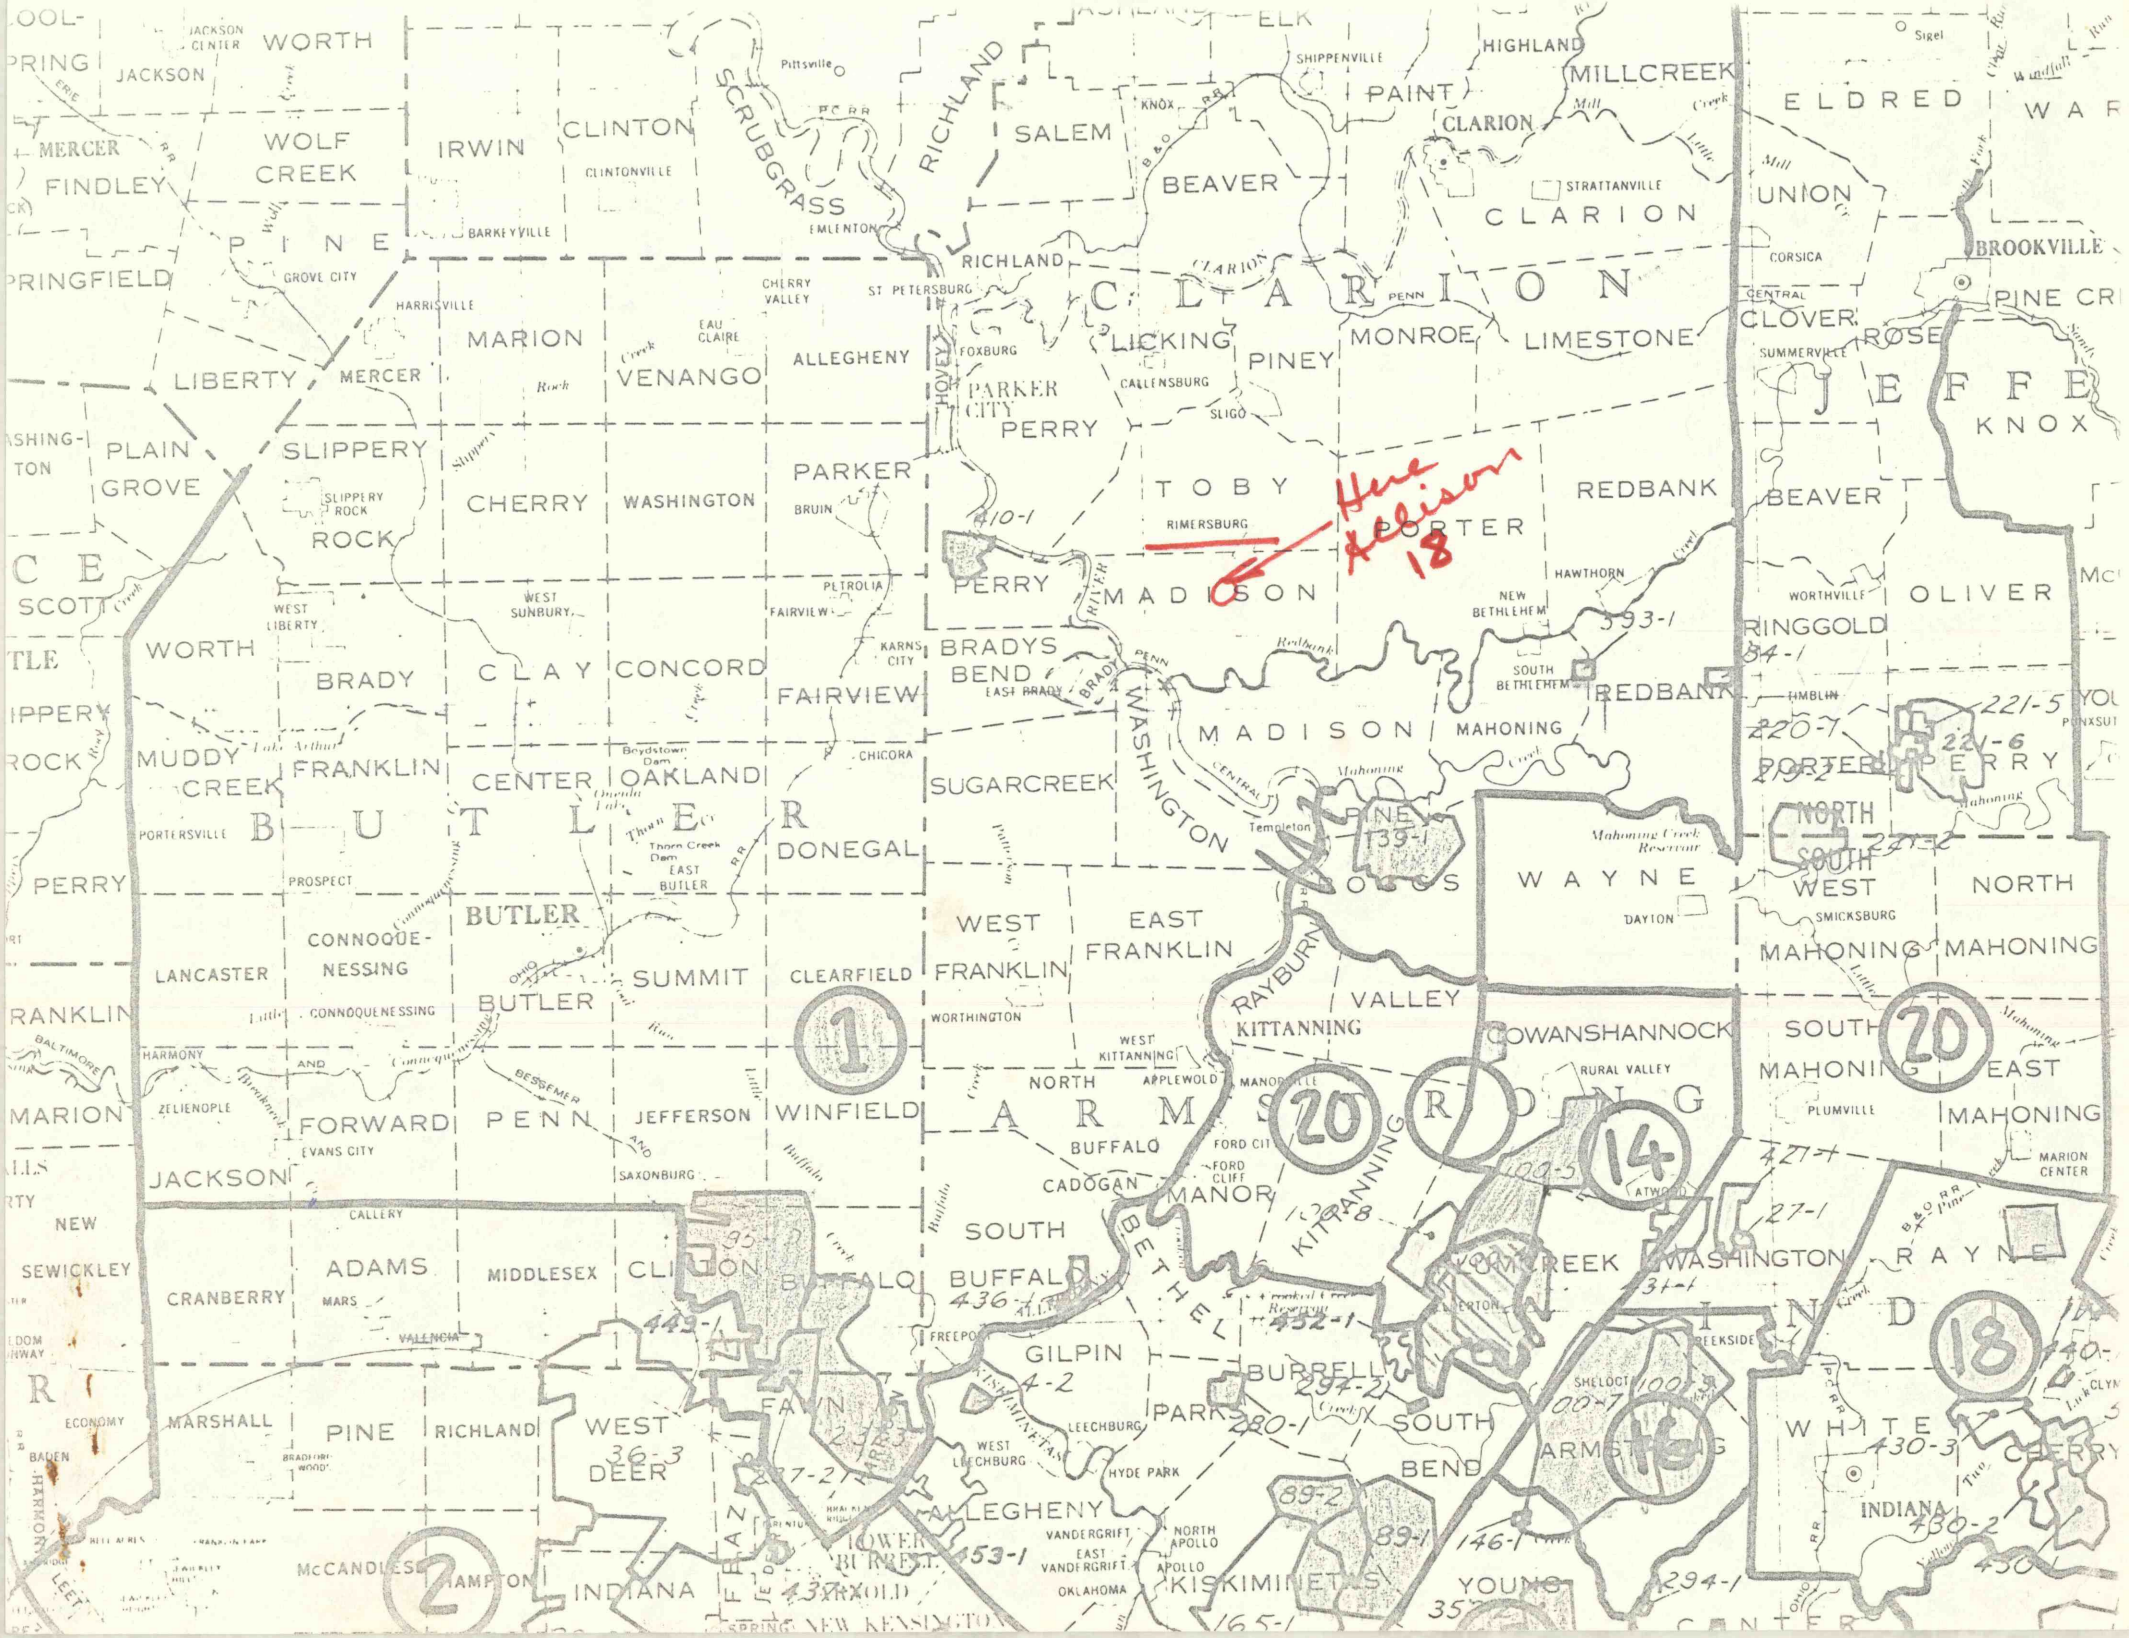
Here Allison 18
CLARION
BUTLER
ARMSTRONG
INDIANA
JEFFERSON
WASHINGTON
WAYNE
MADISON
TOBY
PORTER
REDBANK
BEAVER
PAINT
MILLCREEK
ELDRED
UNION
CLARION
RICHLAND
SALEM
BEAVER
LICKING
PINEY
MONROE
LIMESTONE
CLOVER
ROSE
KNOX
OLIVER
RINGGOLD
PERRY
MARION
VENANGO
ALLEGHENY
PARKER
CHERRY
WASHINGTON
SLIPPERY ROCK
PLAIN GROVE
LIBERTY
MERCER
WORTH
BRADY
CLAY
CONCORD
FAIRVIEW
BRADYS BEND
MUDDY CREEK
FRANKLIN
CENTER
OAKLAND
SUGARCREEK
DONEGAL
PERRY
CONNOQUE-NESSING
SUMMIT
CLEARFIELD
WEST FRANKLIN
EAST FRANKLIN
LANCASTER
FORWARD
PENN
JEFFERSON
WINFIELD
BUFFALO
CADOGAN
MANOR
SOUTH BUFFALO
GILPIN
BURRELL
SOUTH BEND
ALLEGHENY
KISKIMINETAS
CRANBERRY
ADAMS
MIDDLESEX
MARSHALL
PINE
RICHLAND
WEST DEER
EAST DEER
INDIANA
McCANDLESS
HAMPTON
NEW KENSINGTON
KITTANNING
VALLEY
COWANSHANNOCK
SOUTH MAHONING
NORTH MAHONING
EAST MAHONING
WEST MAHONING
SOUTH WEST
NORTH
WHITE
CHERRY
BROOKVILLE
PINE CR
CORSICA
CENTRAL
SUMMERVILLE
WORTHVILLE
TIMBLIN
PORTER
HAWTHORN
NEW BETHLEHEM
SOUTH BETHLEHEM
MAHONING
SMICKSBURG
DAYTON
RURAL VALLEY
PLUMVILLE
MARION CENTER
ATWOOD
SHELOCTA
CREEKSIDE
WEST KITTANNING
APPLEWOLD
MANORVILLE
FORD CITY
FORD CLIFF
WORTHINGTON
FREEPORT
LEECHBURG
WEST LEECHBURG
HYDE PARK
VANDERGRIFT
EAST VANDERGRIFT
NORTH APOLLO
APOLLO
OKLAHOMA
YOUNG
CENTER
SLIGO
CALLENSBURG
FOXBURG
RIMERSBURG
PARKER CITY
EAST BRADY
KARNS CITY
PETROLIA
FAIRVIEW
WEST SUNBURY
BRUIN
CHICORA
EAST BUTLER
PROSPECT
PORTERSVILLE
EVANS CITY
SAXONBURG
VALENCIA
MARS
ZELIENOPLE
HARMONY
CALLERY
SEWICKLEY
ECONOMY
BADEN
EMLENTON
CLINTONVILLE
BARKEYVILLE
GROVE CITY
HARRISVILLE
CHERRY VALLEY
ST PETERSBURG
EAU CLAIRE
WEST LIBERTY
SLIPPERY ROCK
STRATTANVILLE
SHIPPENVILLE
Pittsville
Sigel
JACKSON CENTER
JACKSON
WORTH
WOLF CREEK
IRWIN
CLINTON
FINDLEY
MERCER
SPRINGFIELD
SCRUBGRASS
Mahoning Creek Reservoir
Beydstown Dam
Thorn Creek Dam
Crooked Creek Lake
Lake Arthur
Connoquenessing Creek
Little Connoquenessing Creek
Buffalo Creek
Little Buffalo Creek
Bear Run
Redbank Creek
Mahoning Creek
Little Mahoning Creek
Rayburn Run
Pine Run
Pine Creek
Mill Creek
Little Mill Creek
Wildcat Run
Sandy Lick Creek
Two Lick Creek
Yellow Creek
Cherry Run
Big Run
Mahoning
Templeton
Penn
Central
Howe
410-1
139-1
393-1
220-1
221-5
221-6
432-1
294-2
280-1
146-1
89-2
89-1
165-1
453-1
449-1
436-1
227-2
227-1
36-3
23-3
4-2
31-1
27-1
100-5
100-7
430-3
430-2
430
18
14
20
2
1