


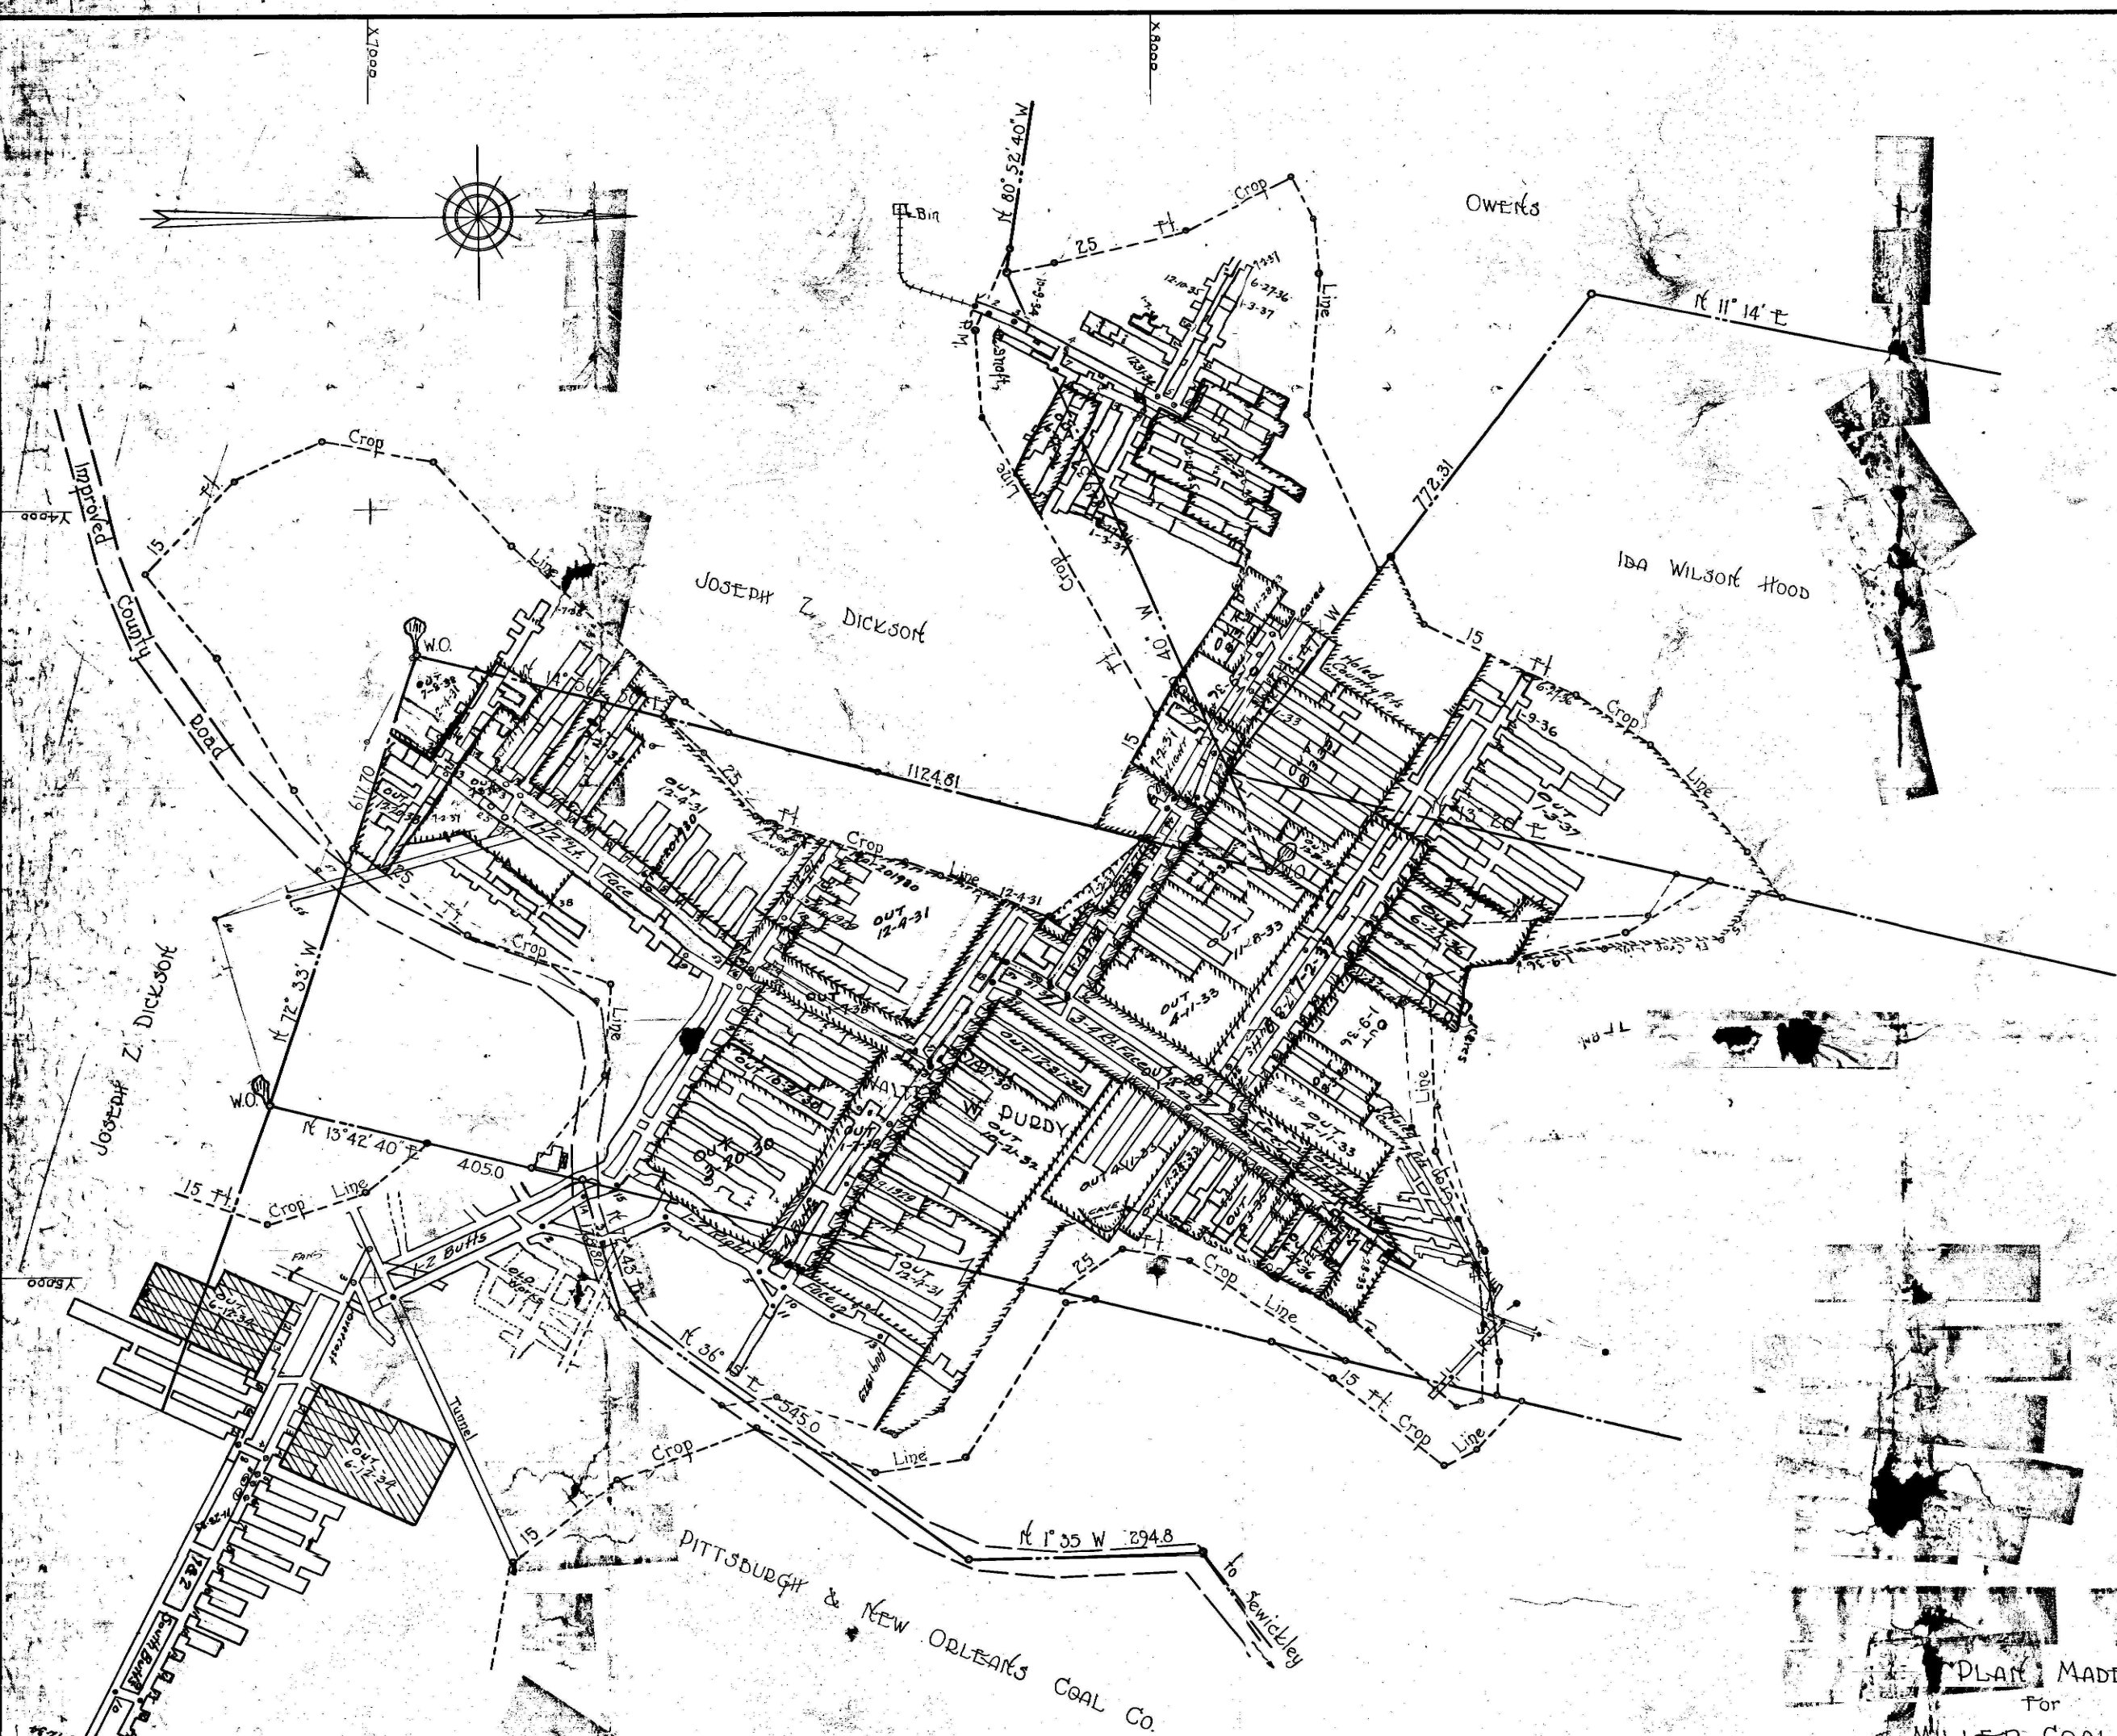

PLAN MADE
For
MILLER COAL CO.
Situate in
TINDELY W. ALLEGHENY CO. PA.
Scale 1" = 200' 1929 G.A. Reed Pgh., Pa.

Coal Mined 12-20-38

1253