


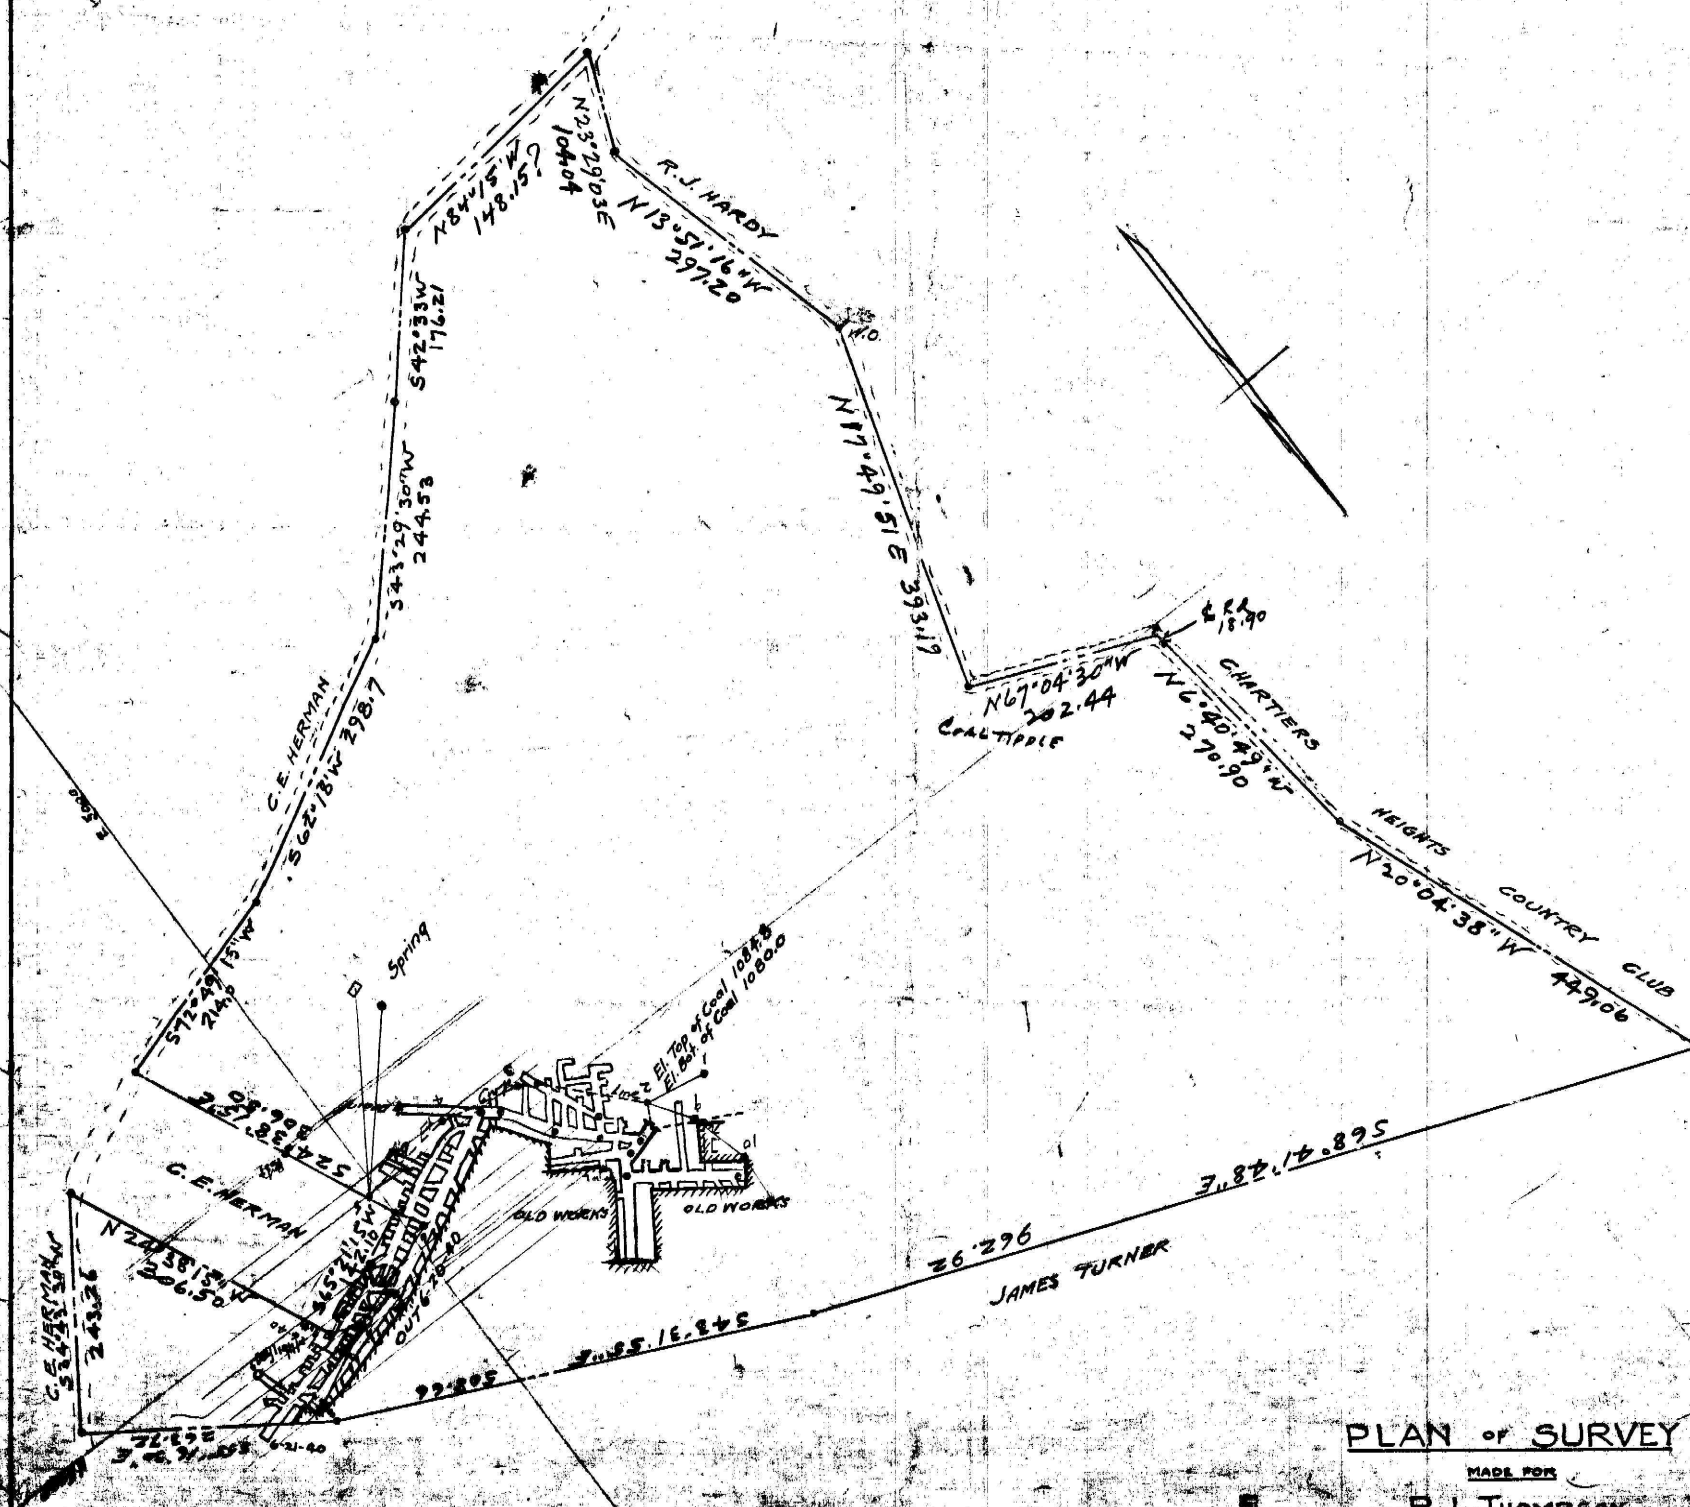

PLAN of SURVEY

MADE FOR

R. L. THOMPSON

Situate in Robinson Twp., Allegh. Co., Pa.

Scale 1"=100' Nov. 1900 Guy A. Reed - 3055

