


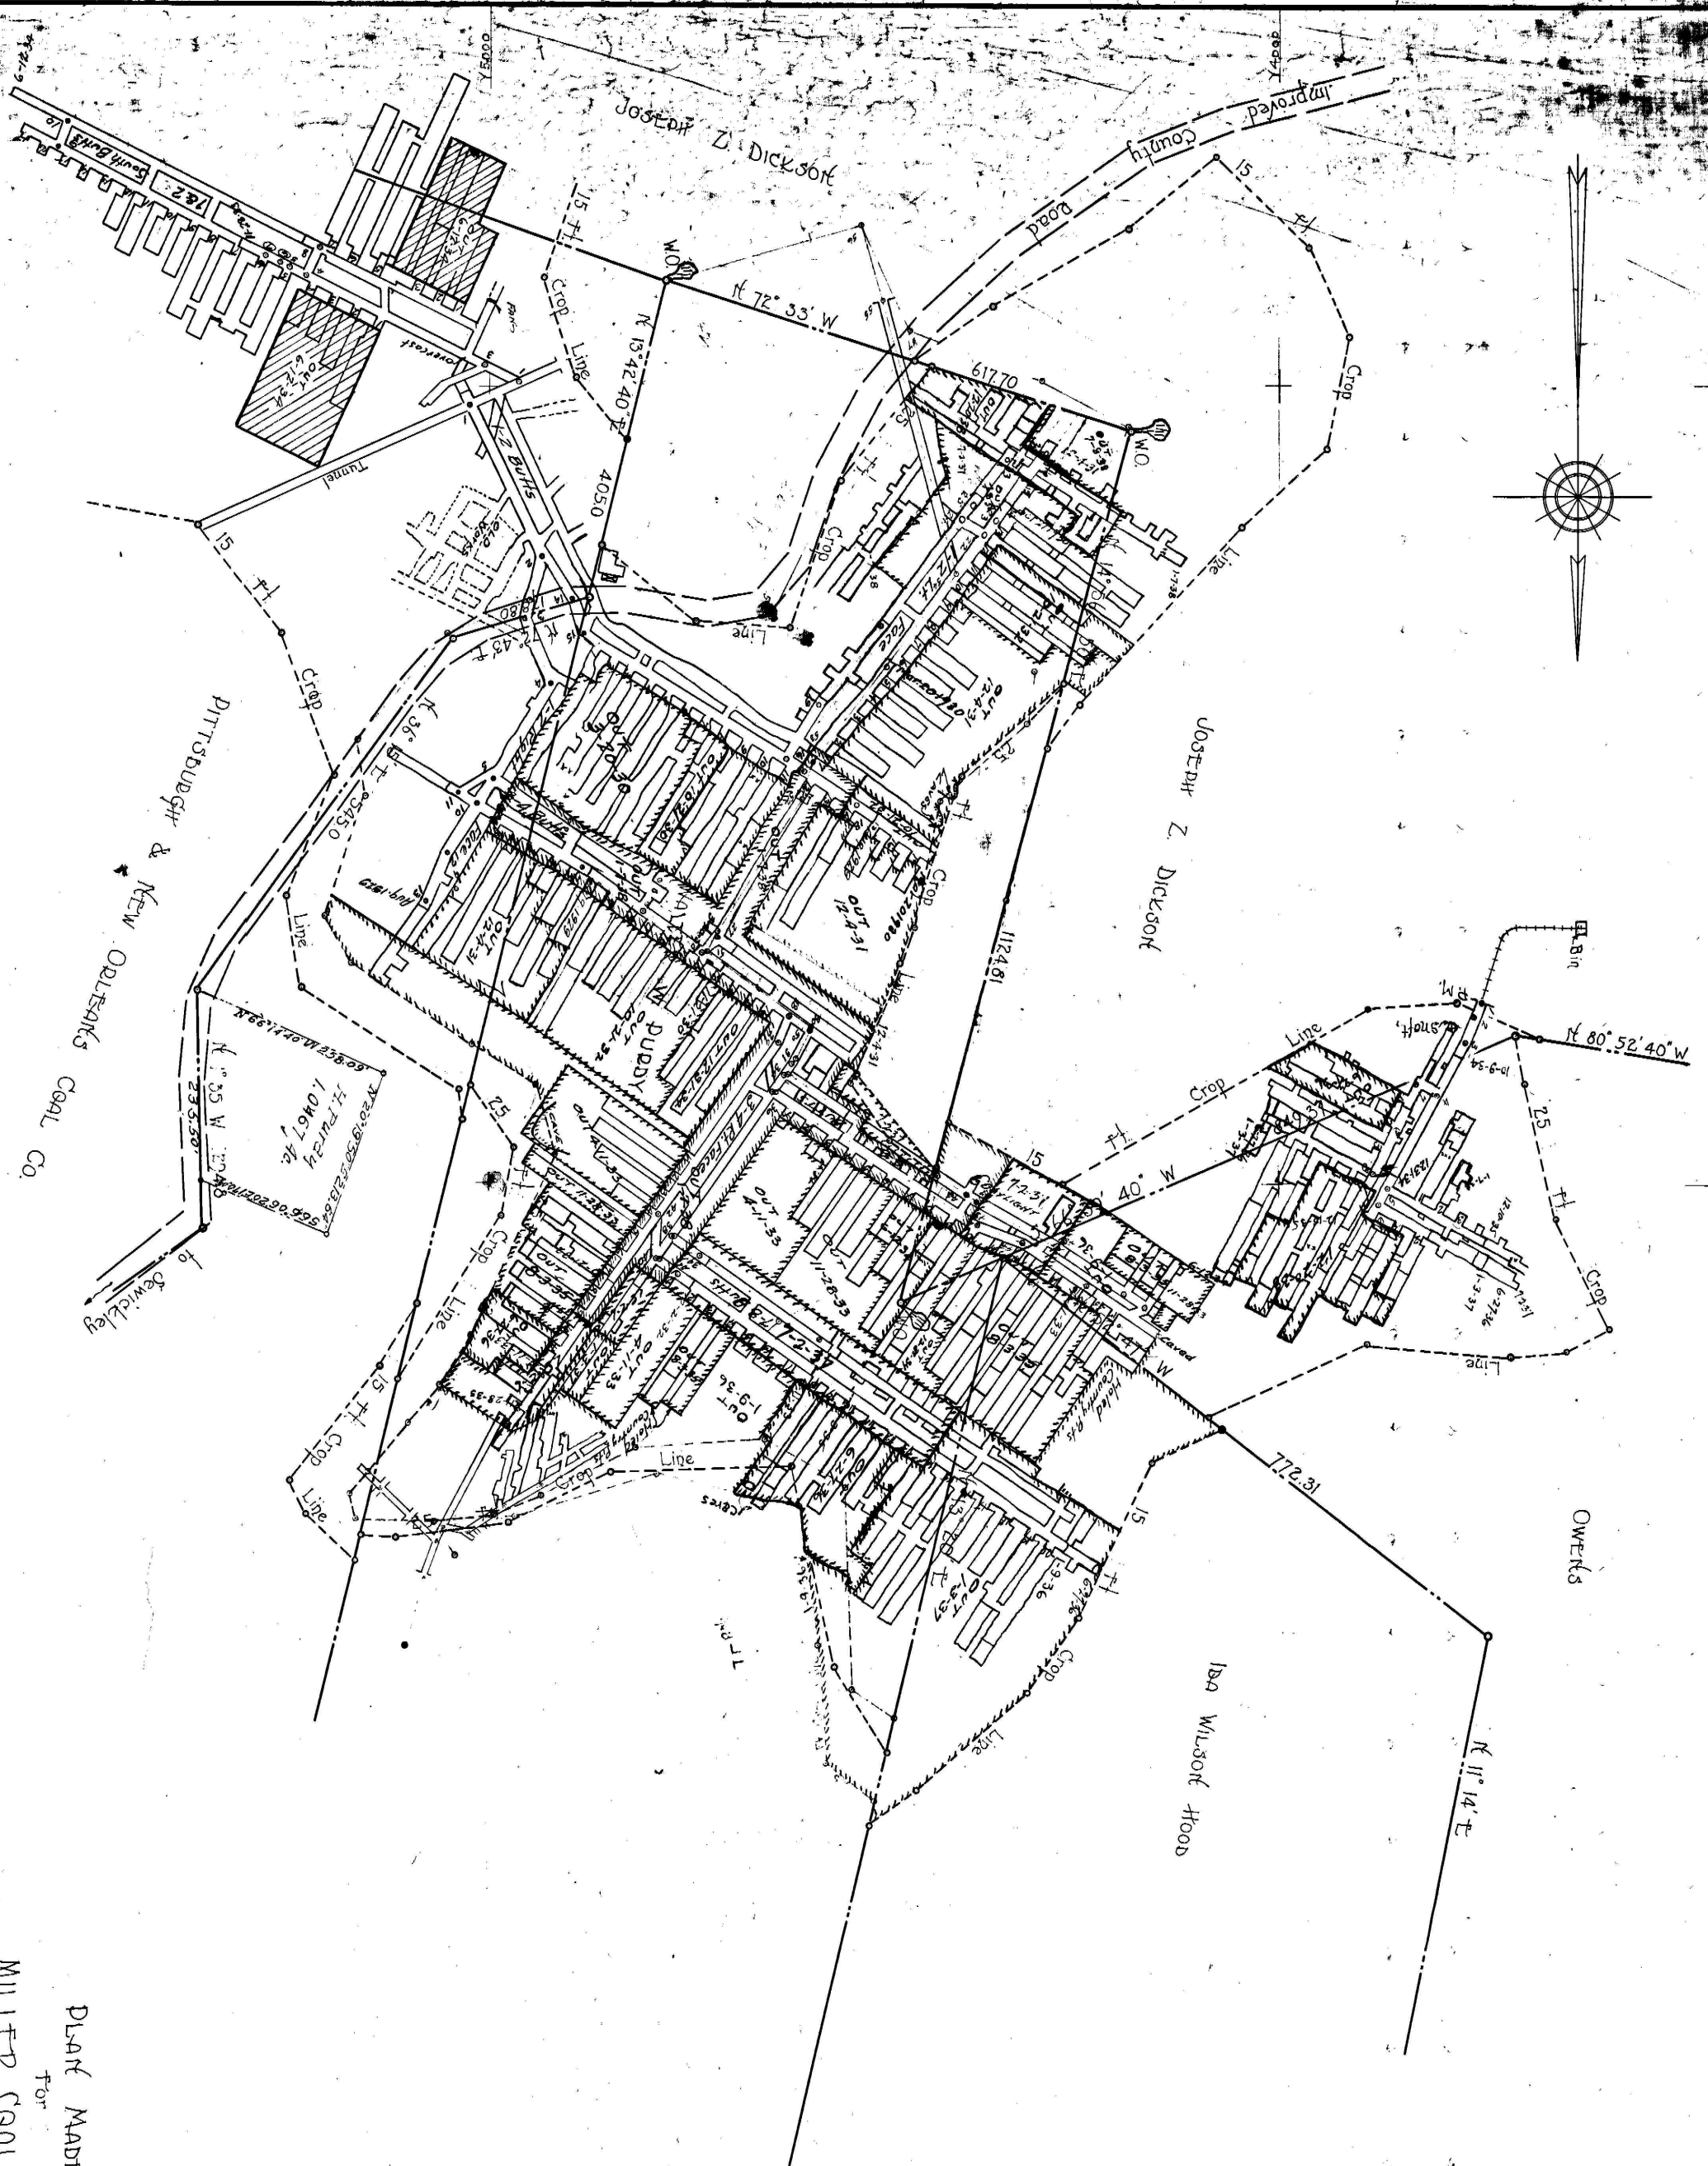

PLAN MADE
 FOR
 MILLER COAL CO.
 Situate in
 FINDLEY TWP. ALLEGHENY CO. PA.
 Scale 1"=100' Sept 1929. G.A. Reed
 Pgh., Pa.

Coal Mined