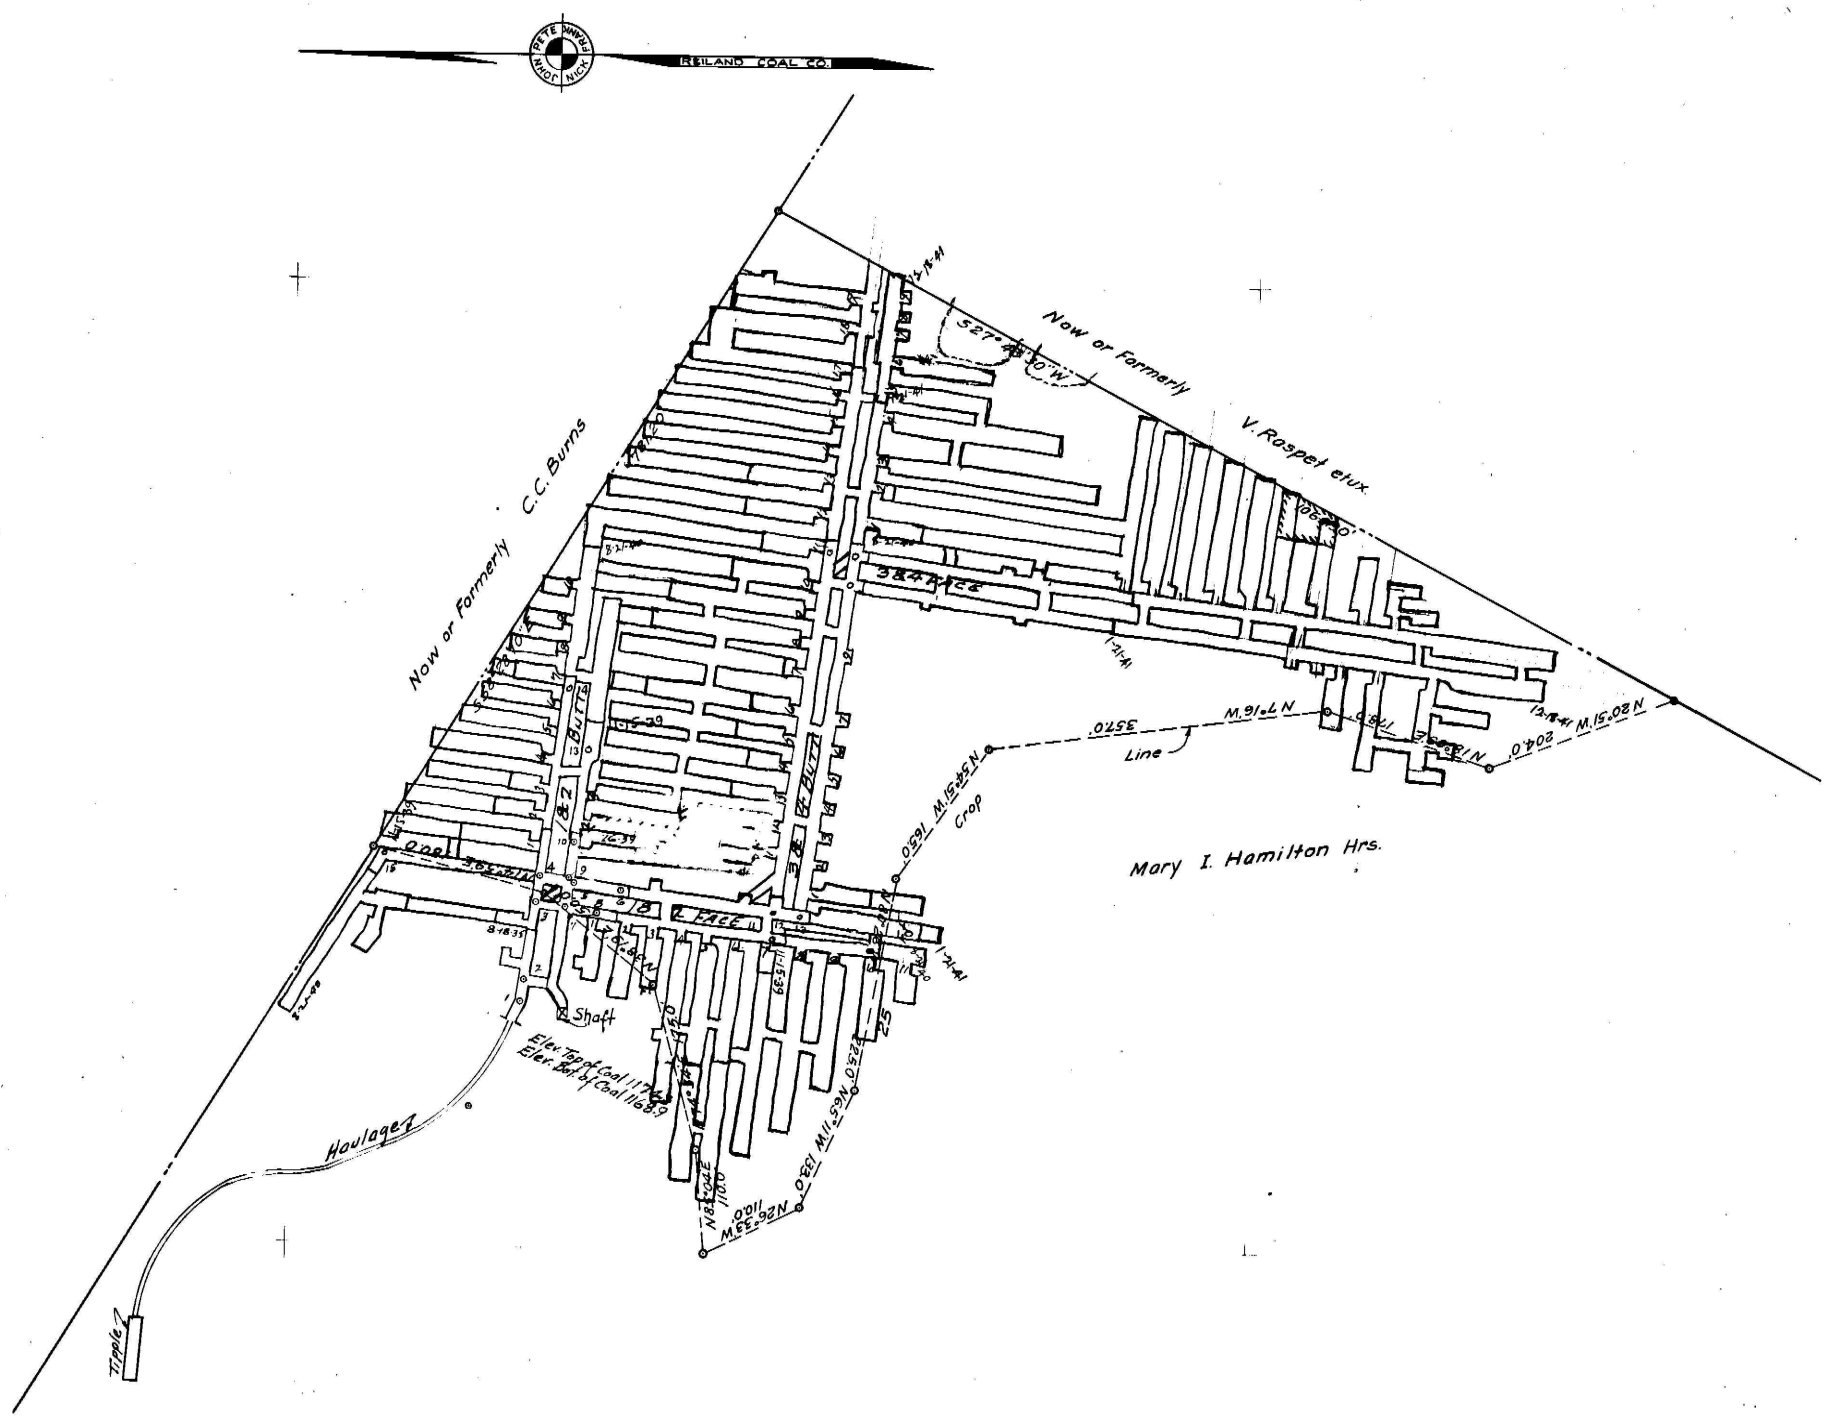

REILAND COAL CO.

MINE NO. 2

FINDLAY TWP. ALLE. CO. PA.

SCALE 1"=100' APRIL 1938 GUY A. REED

COAL MINED

N.B. 21