


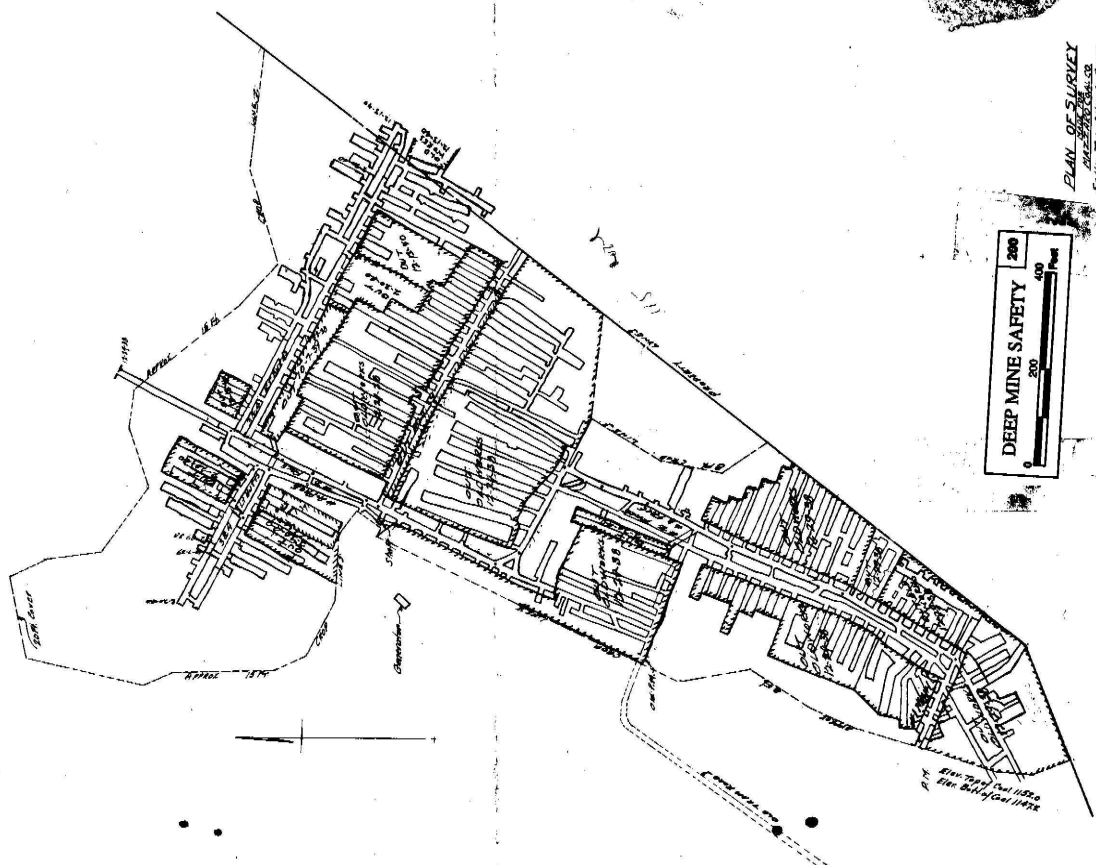

PLAN OF SURVEY
 DEEP MINE SAFETY
 DEPT. OF MINES
 DIVISION OF MINING

