No. 67

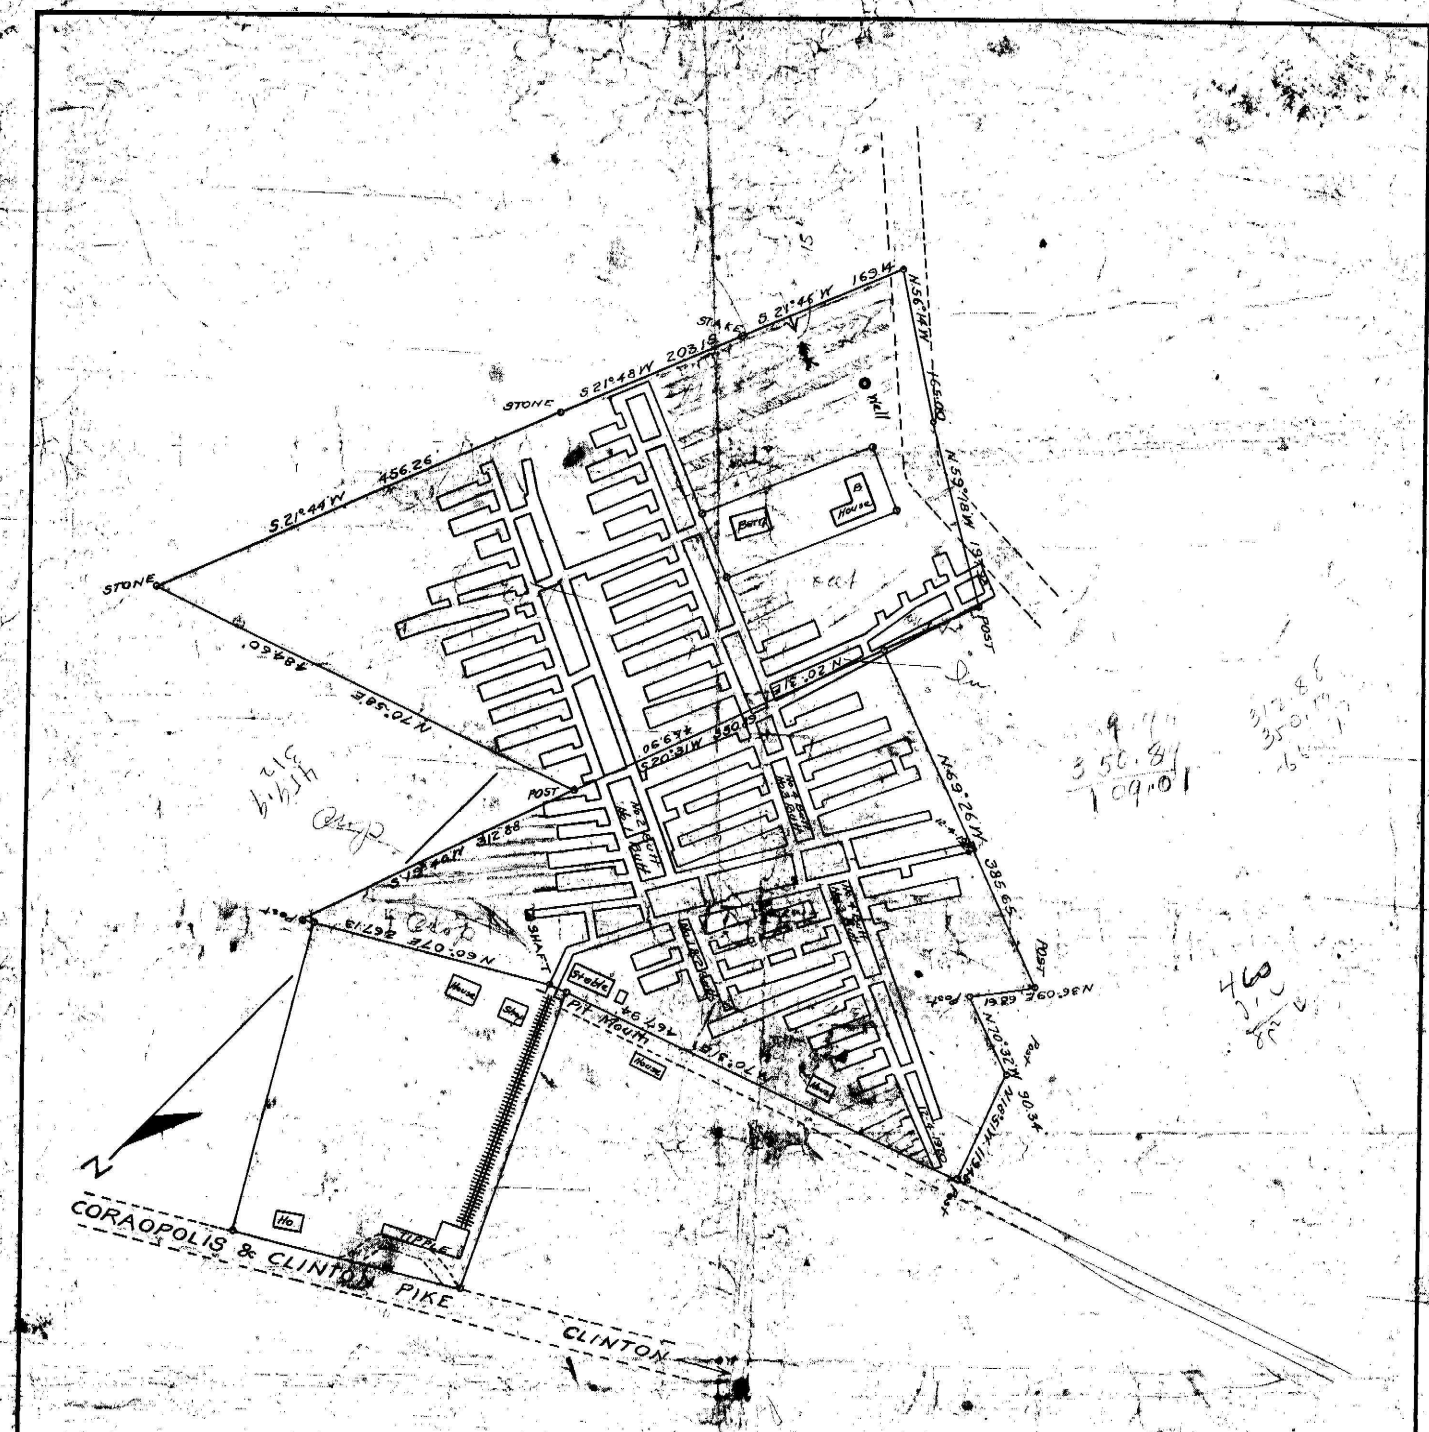

The C. & C. Coal Co.

PLAN OF MINE

OWNED BY

LEBANON BLOCK COAL CO.

CLINTON-FINDLAY TWP. ALLE. CO., PA.

SCALE 1" 100' 1929.

DEEP MINE SAFETY 100

0 100 200 Feet