


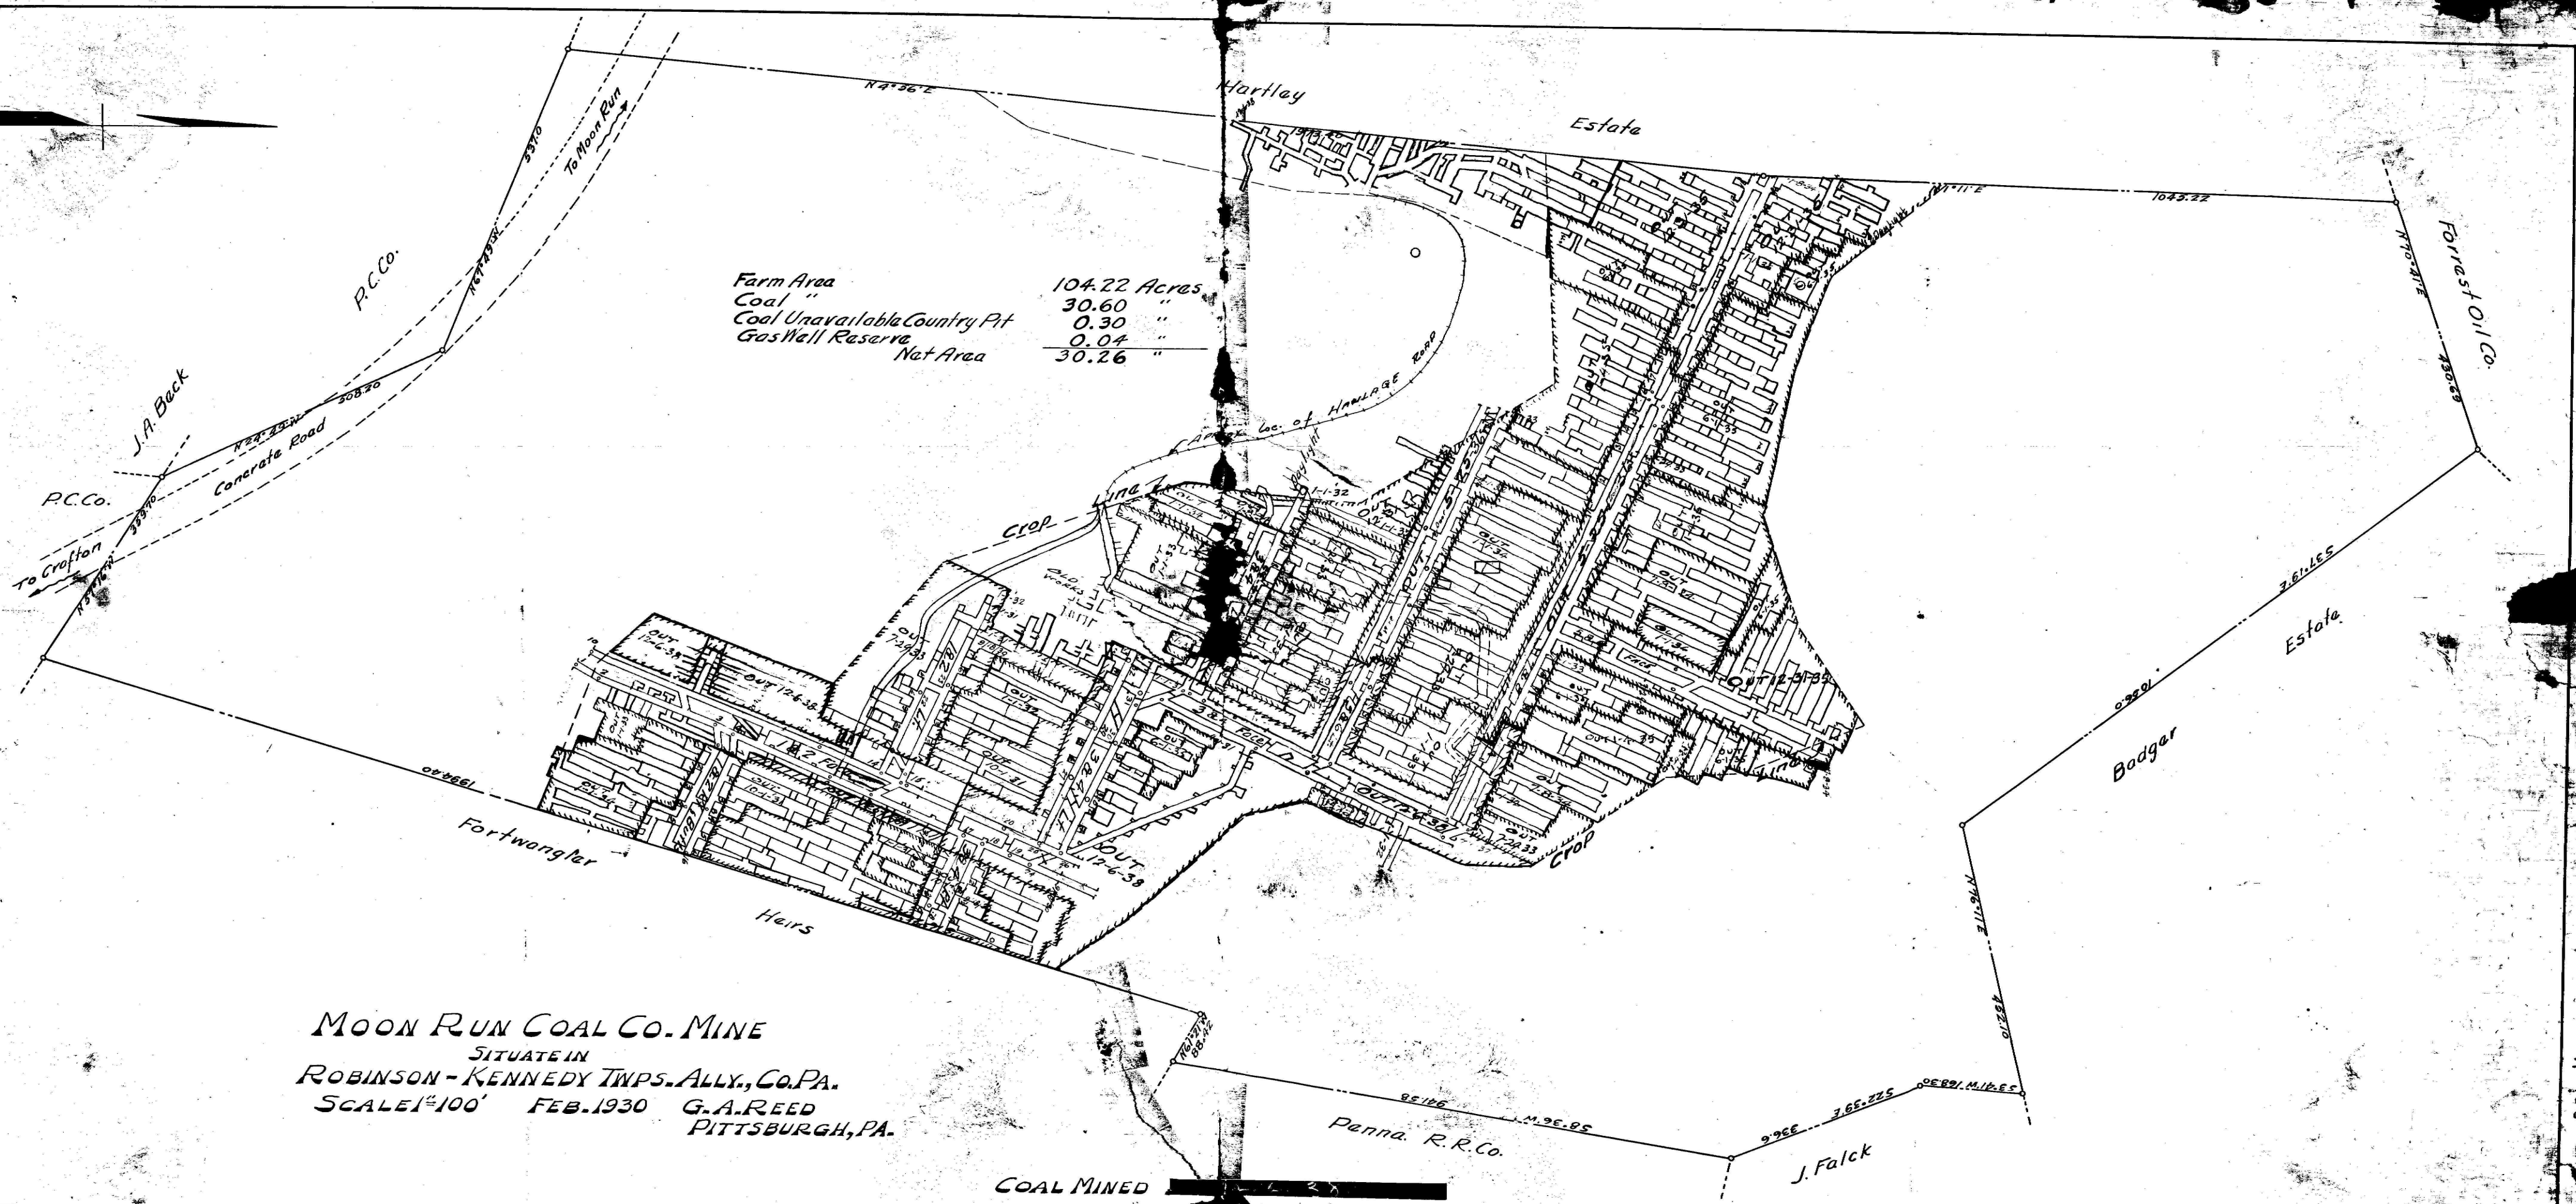

Farm Area	104.22 Acres
Coal "	30.60 "
Coal Unavailable Country Pft	0.30 "
Gas Well Reserve	0.04 "
Nat Area	30.26 "

MOON RUN COAL CO. MINE
SITUATE IN
ROBINSON-KENNEDY TWPS. ALLEGHENY CO., PA.
SCALE 1"=100' FEB. 1930 G.A. REED
PITTSBURGH, PA.