


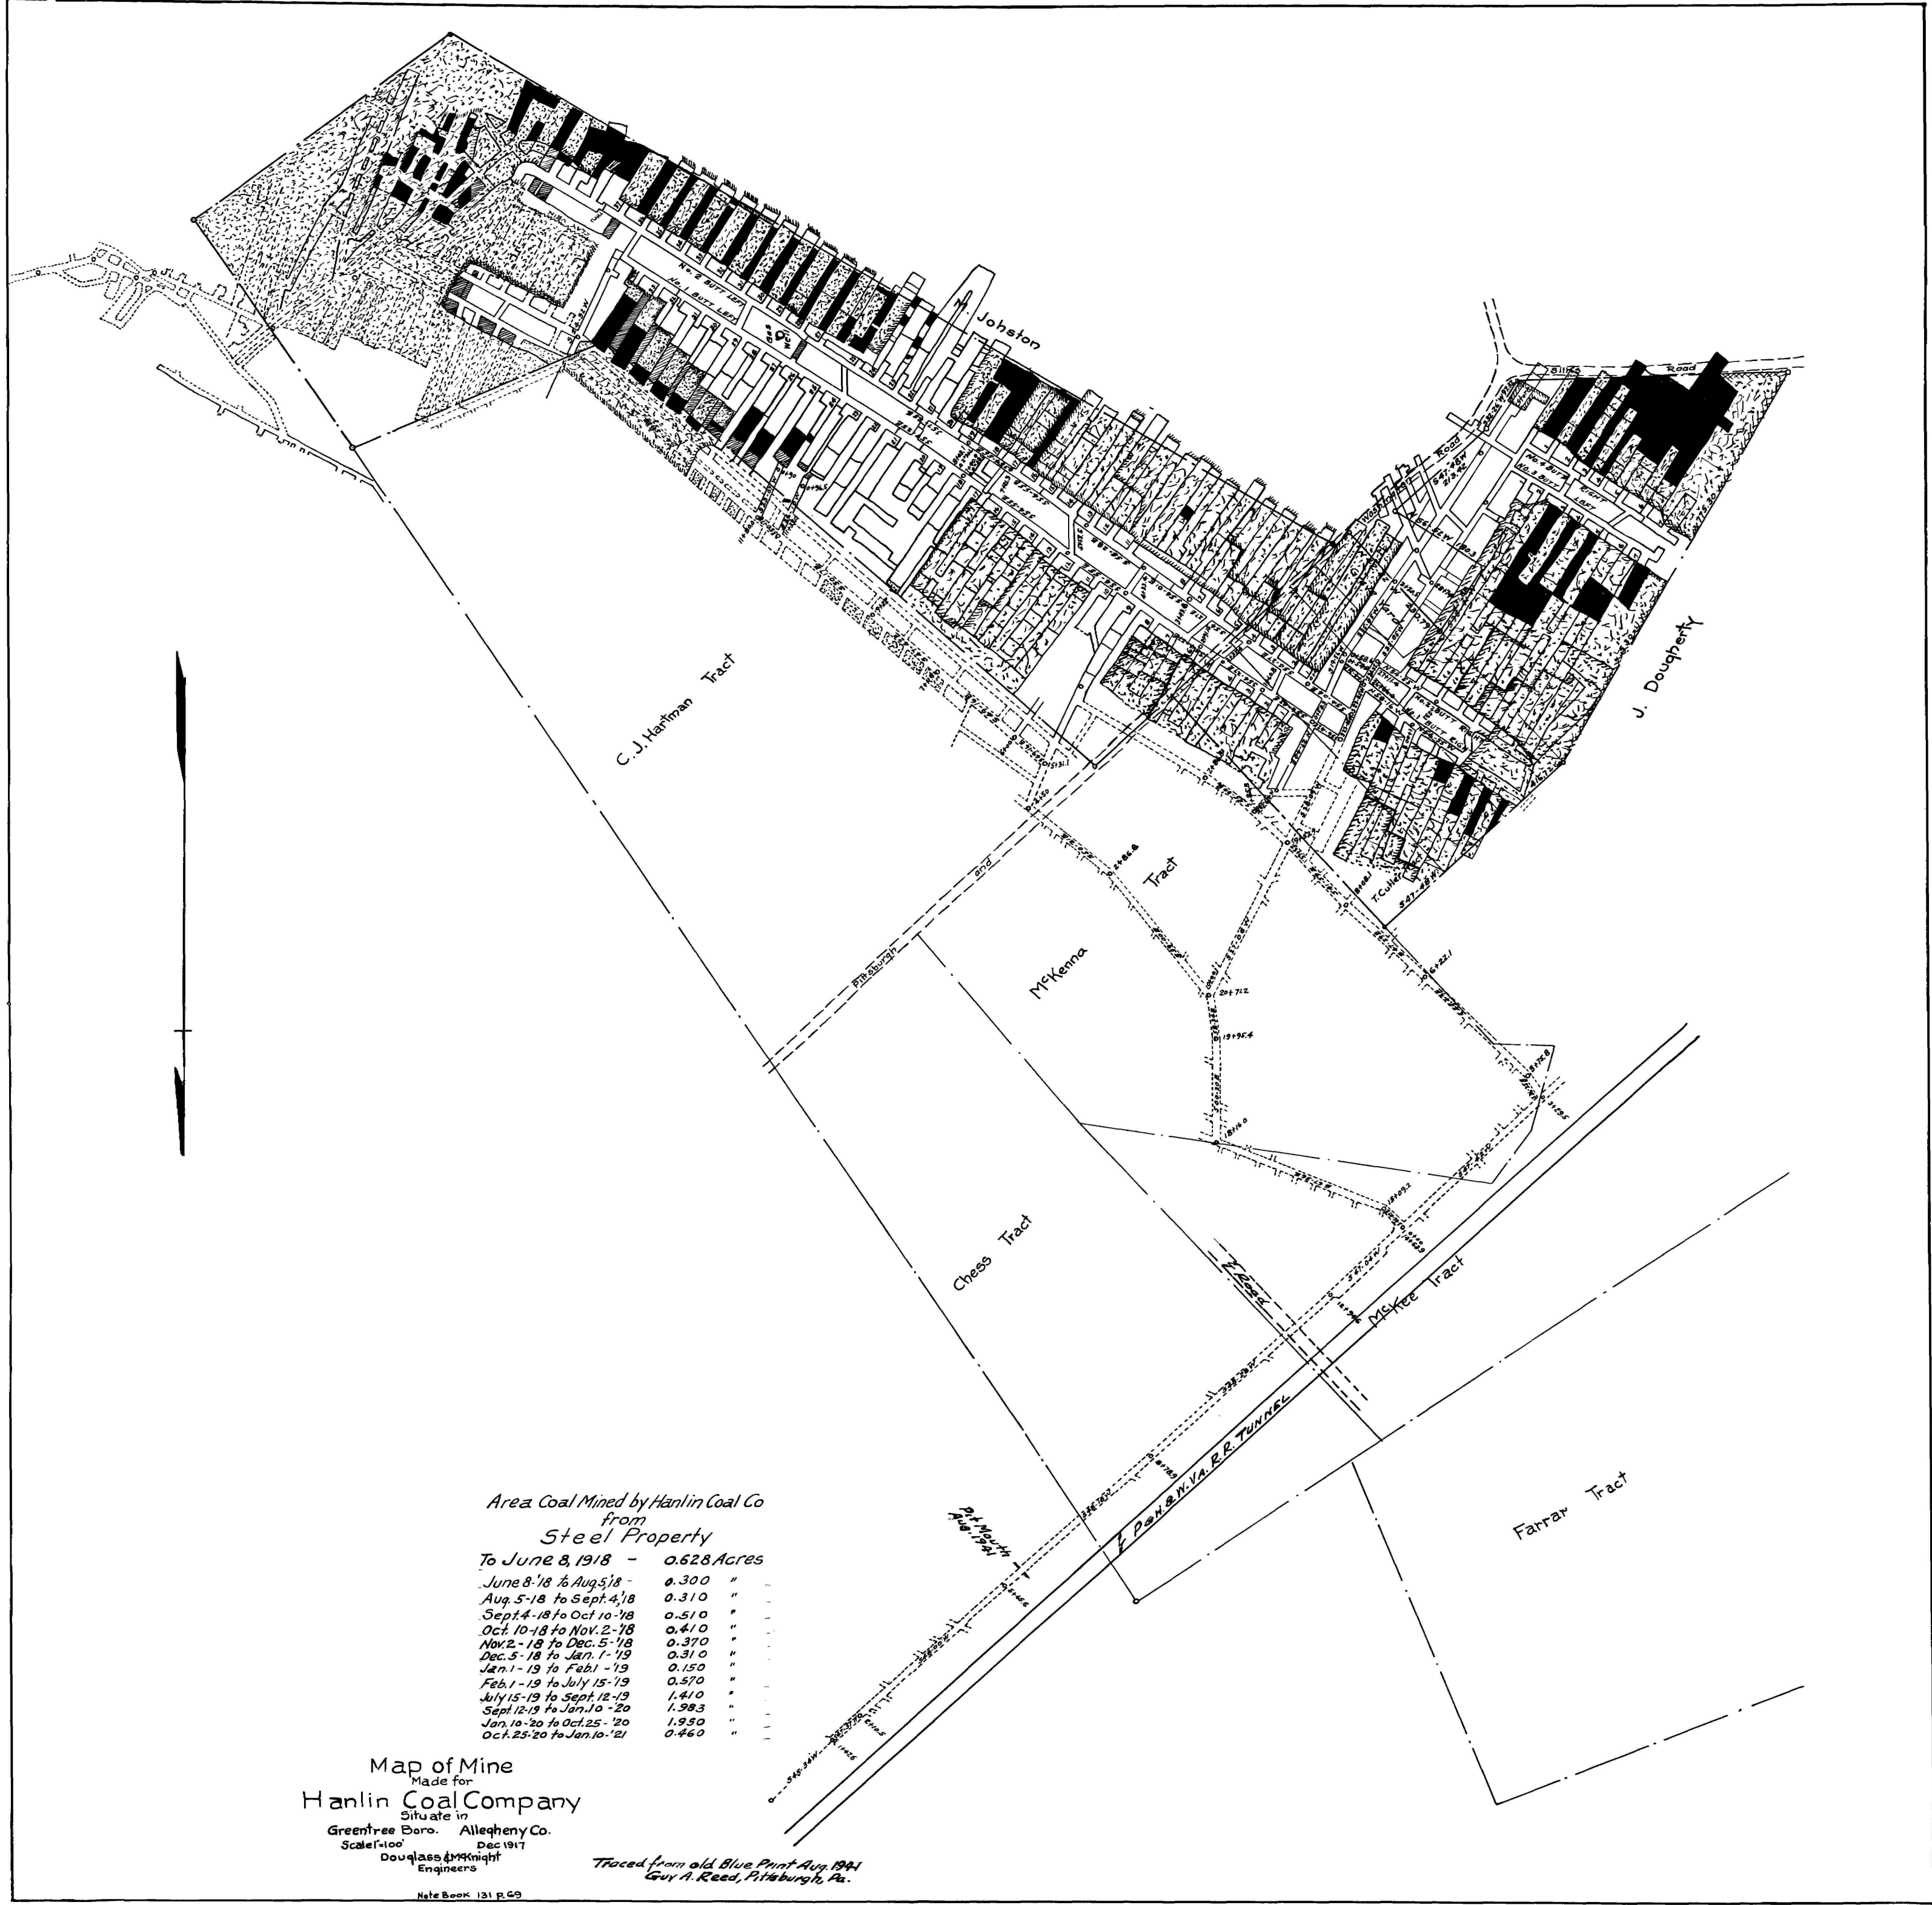

Area Coal Mined by Hanlin Coal Co
from
Steel Property

To June 8, 1918 -	0.628 Acres
June 8-'18 to Aug. 5-'18 -	0.300 "
Aug. 5-'18 to Sept. 4-'18	0.310 "
Sept. 4-'18 to Oct. 10-'18	0.510 "
Oct. 10-'18 to Nov. 2-'18	0.410 "
Nov. 2-'18 to Dec. 5-'18	0.370 "
Dec. 5-'18 to Jan. 1-'19	0.310 "
Jan. 1-'19 to Feb. 1-'19	0.150 "
Feb. 1-'19 to July 15-'19	0.570 "
July 15-'19 to Sept. 12-'19	1.410 "
Sept. 12-'19 to Jan. 10-'20	1.983 "
Jan. 10-'20 to Oct. 25-'20	1.950 "
Oct. 25-'20 to Jan. 10-'21	0.460 "

Map of Mine
Made for
Hanlin Coal Company
Situate in
Greentree Boro. Allegheny Co.
Scale 1"=100'
Dec 1917
Douglas & McKnight
Engineers

Traced from old Blue Print Aug. 1941
Guy A. Reed, Pittsburgh, Pa.