CONSOLIDATION COAL COMPANY

DILWORTH MINE

36-04281

RICES LANDING BORO.
GREENE COUNTY PA.

SCALE 1" = 200'

MAP PREPARED AS OF DECEMBER 31, 2002
PROJECTED TO FINAL MAP
CLOSE LOOP SURVEY ACCURACY 1:15,000
INDIVIDUAL RESPONSIBLE FOR INFORMATION ON MAP:

THESE MAPS SATISFY THE REQUIREMENTS OF BOTH 75.372 & 75.1200 AS OF THE DATE PREPARED.

THERE ARE NO KNOWN WORKINGS ABOVE OR BELOW THIS MINE.

OXYGEN CONTENT AT BLEEDER EVALUATION POINTS IS GREATER THAN 19.5 %

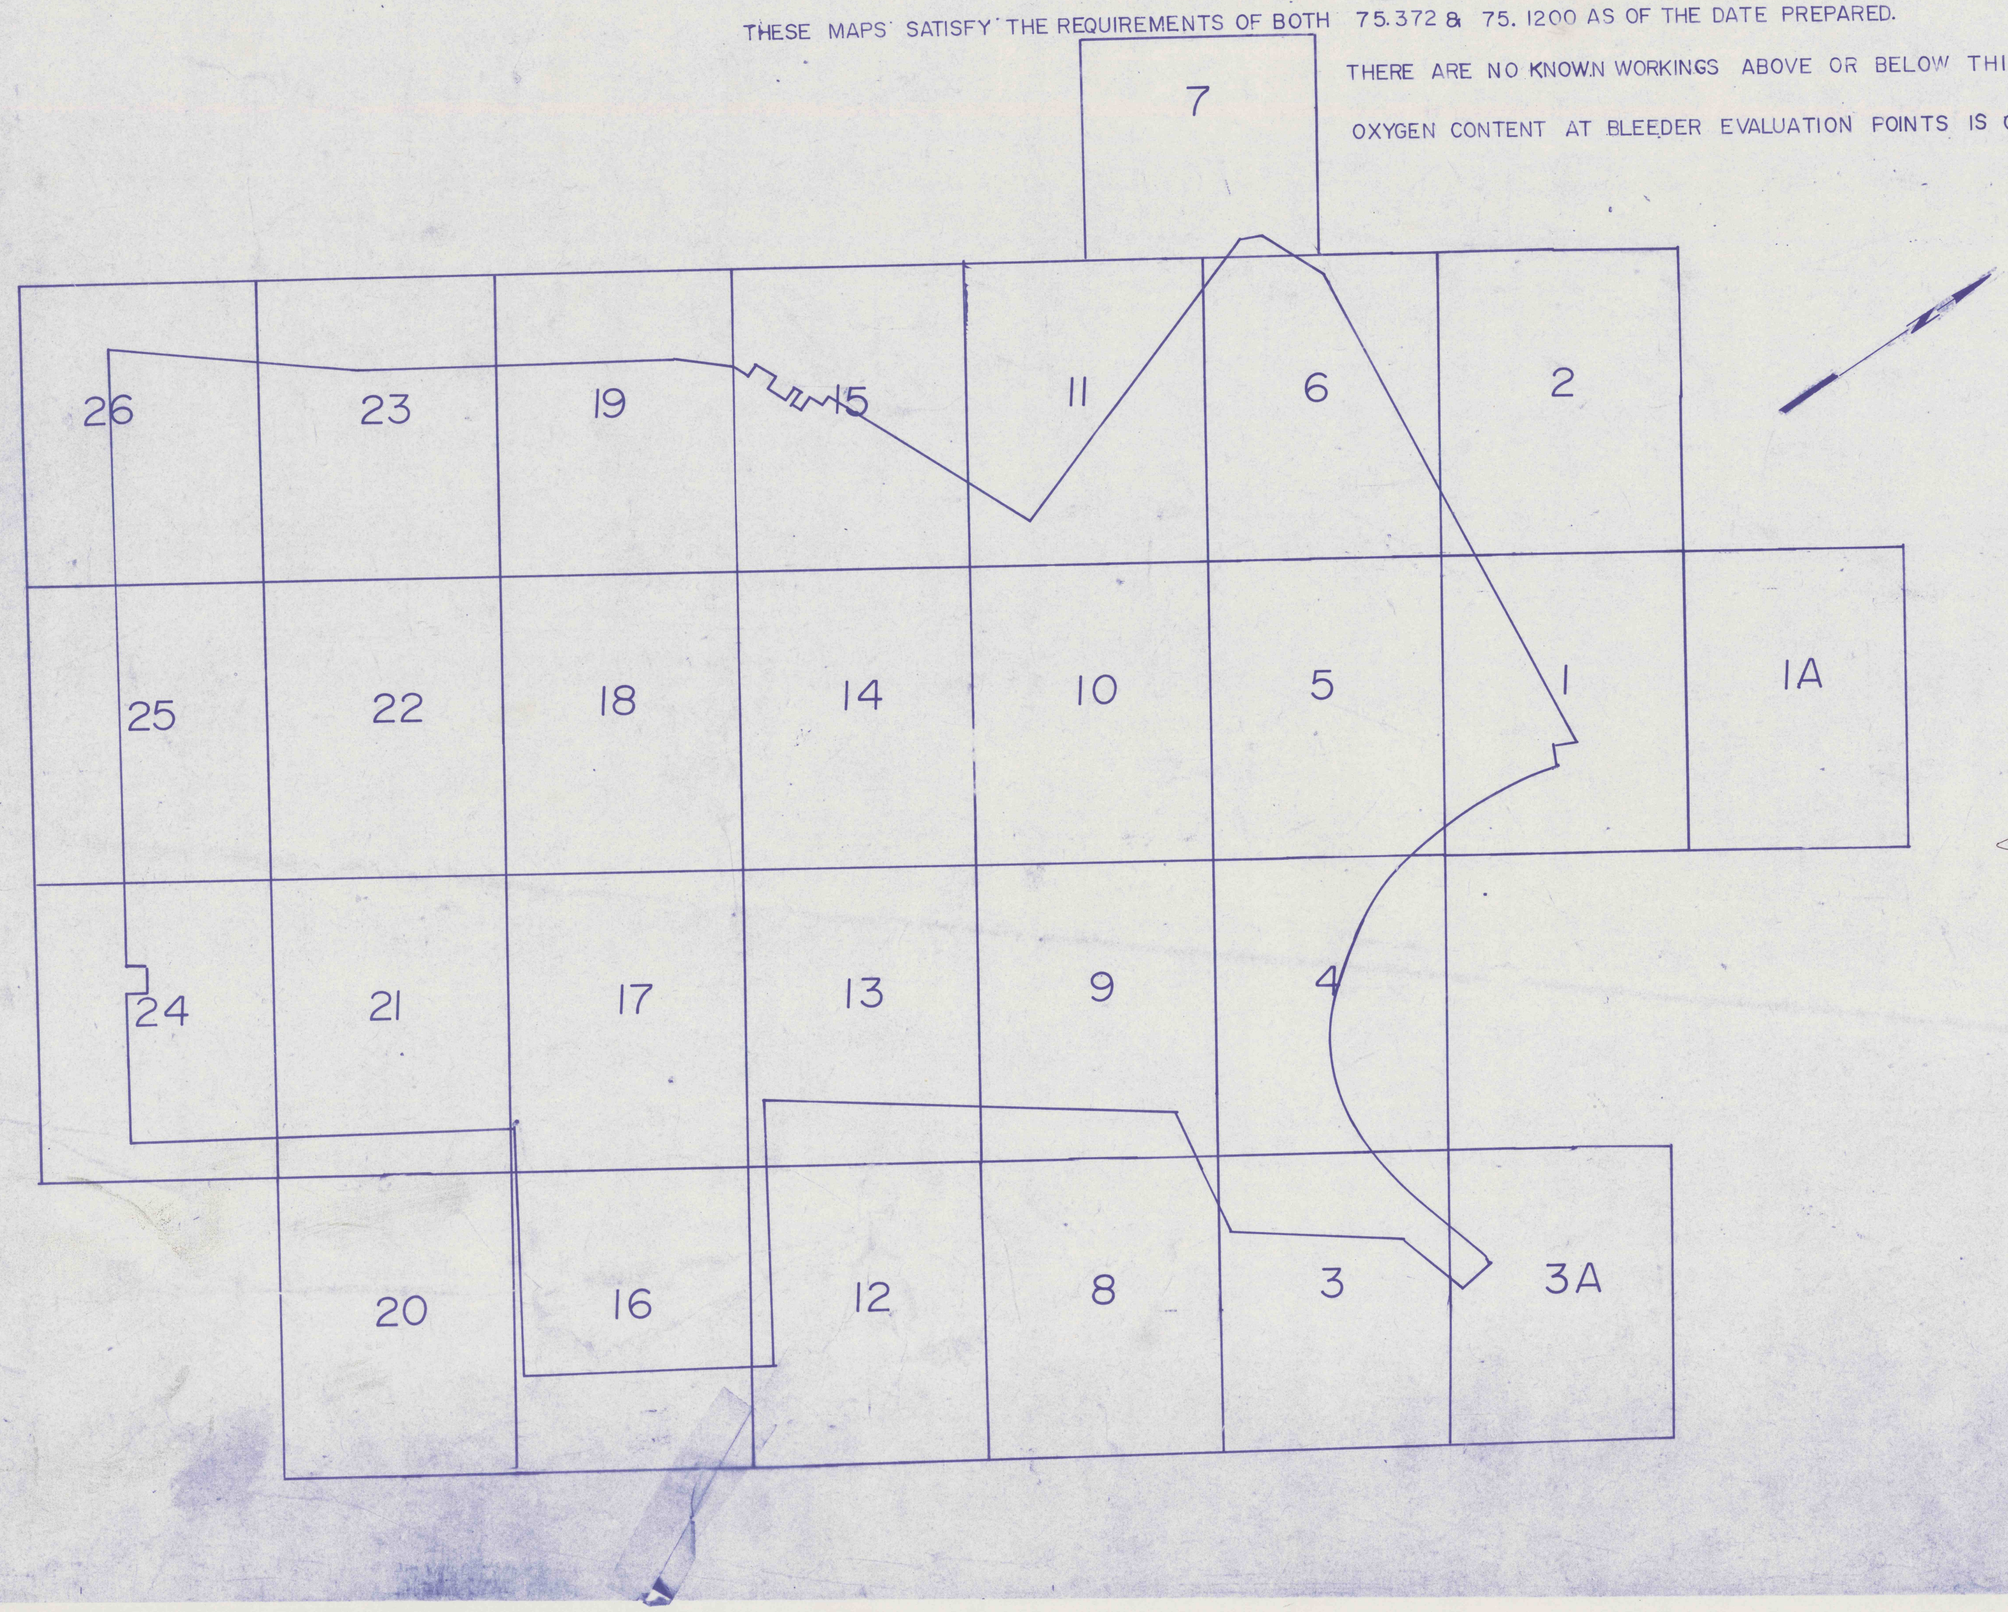

COMMONWEALTH OF PENNSYLVANIA
REGISTERED PROFESSIONAL
JAMES G. METCALFE
ENGINEER

James G. Metcalfe

LEGEND

--530-- BOTTOM OF COAL ELEVATION
~~TD~~ TRACK DOOR K KENNEDY STOPPING
I, II STOPPING $ SEAL
Φ, Φ STOPPING WITH MAN DOOR
REGULATOR
OVERCAST ⊗ OVERCAST WITH MANDOOR
INTAKE / RETURN AIR DIRECTION ~→ AIR LEAKAGE
PRIMARY ESCAPEWAY ALTERNATE ESCAPEWAY
AIR LOCK SYSTEM
OIL OR GAS WELL
OVERPASS ⊗ OVERCAST WITH BLOCK OUT
TRACK PRIMARY ESCAPEWAY & TRACK ENTRY DURING DEVELOPMENT
BELT
VENTILATION BOREHOLE (GOB DE-GAS HOLE)
CLOSED REGULATOR
WATER AREA
STOPPING WITH BLOCK(S) OUT
STOPPING WITH MAN DOOR & BLOCK(S) OUT
BOX CHECK △ CO MONITOR
STREAM
POND
GOB GOB GOB