


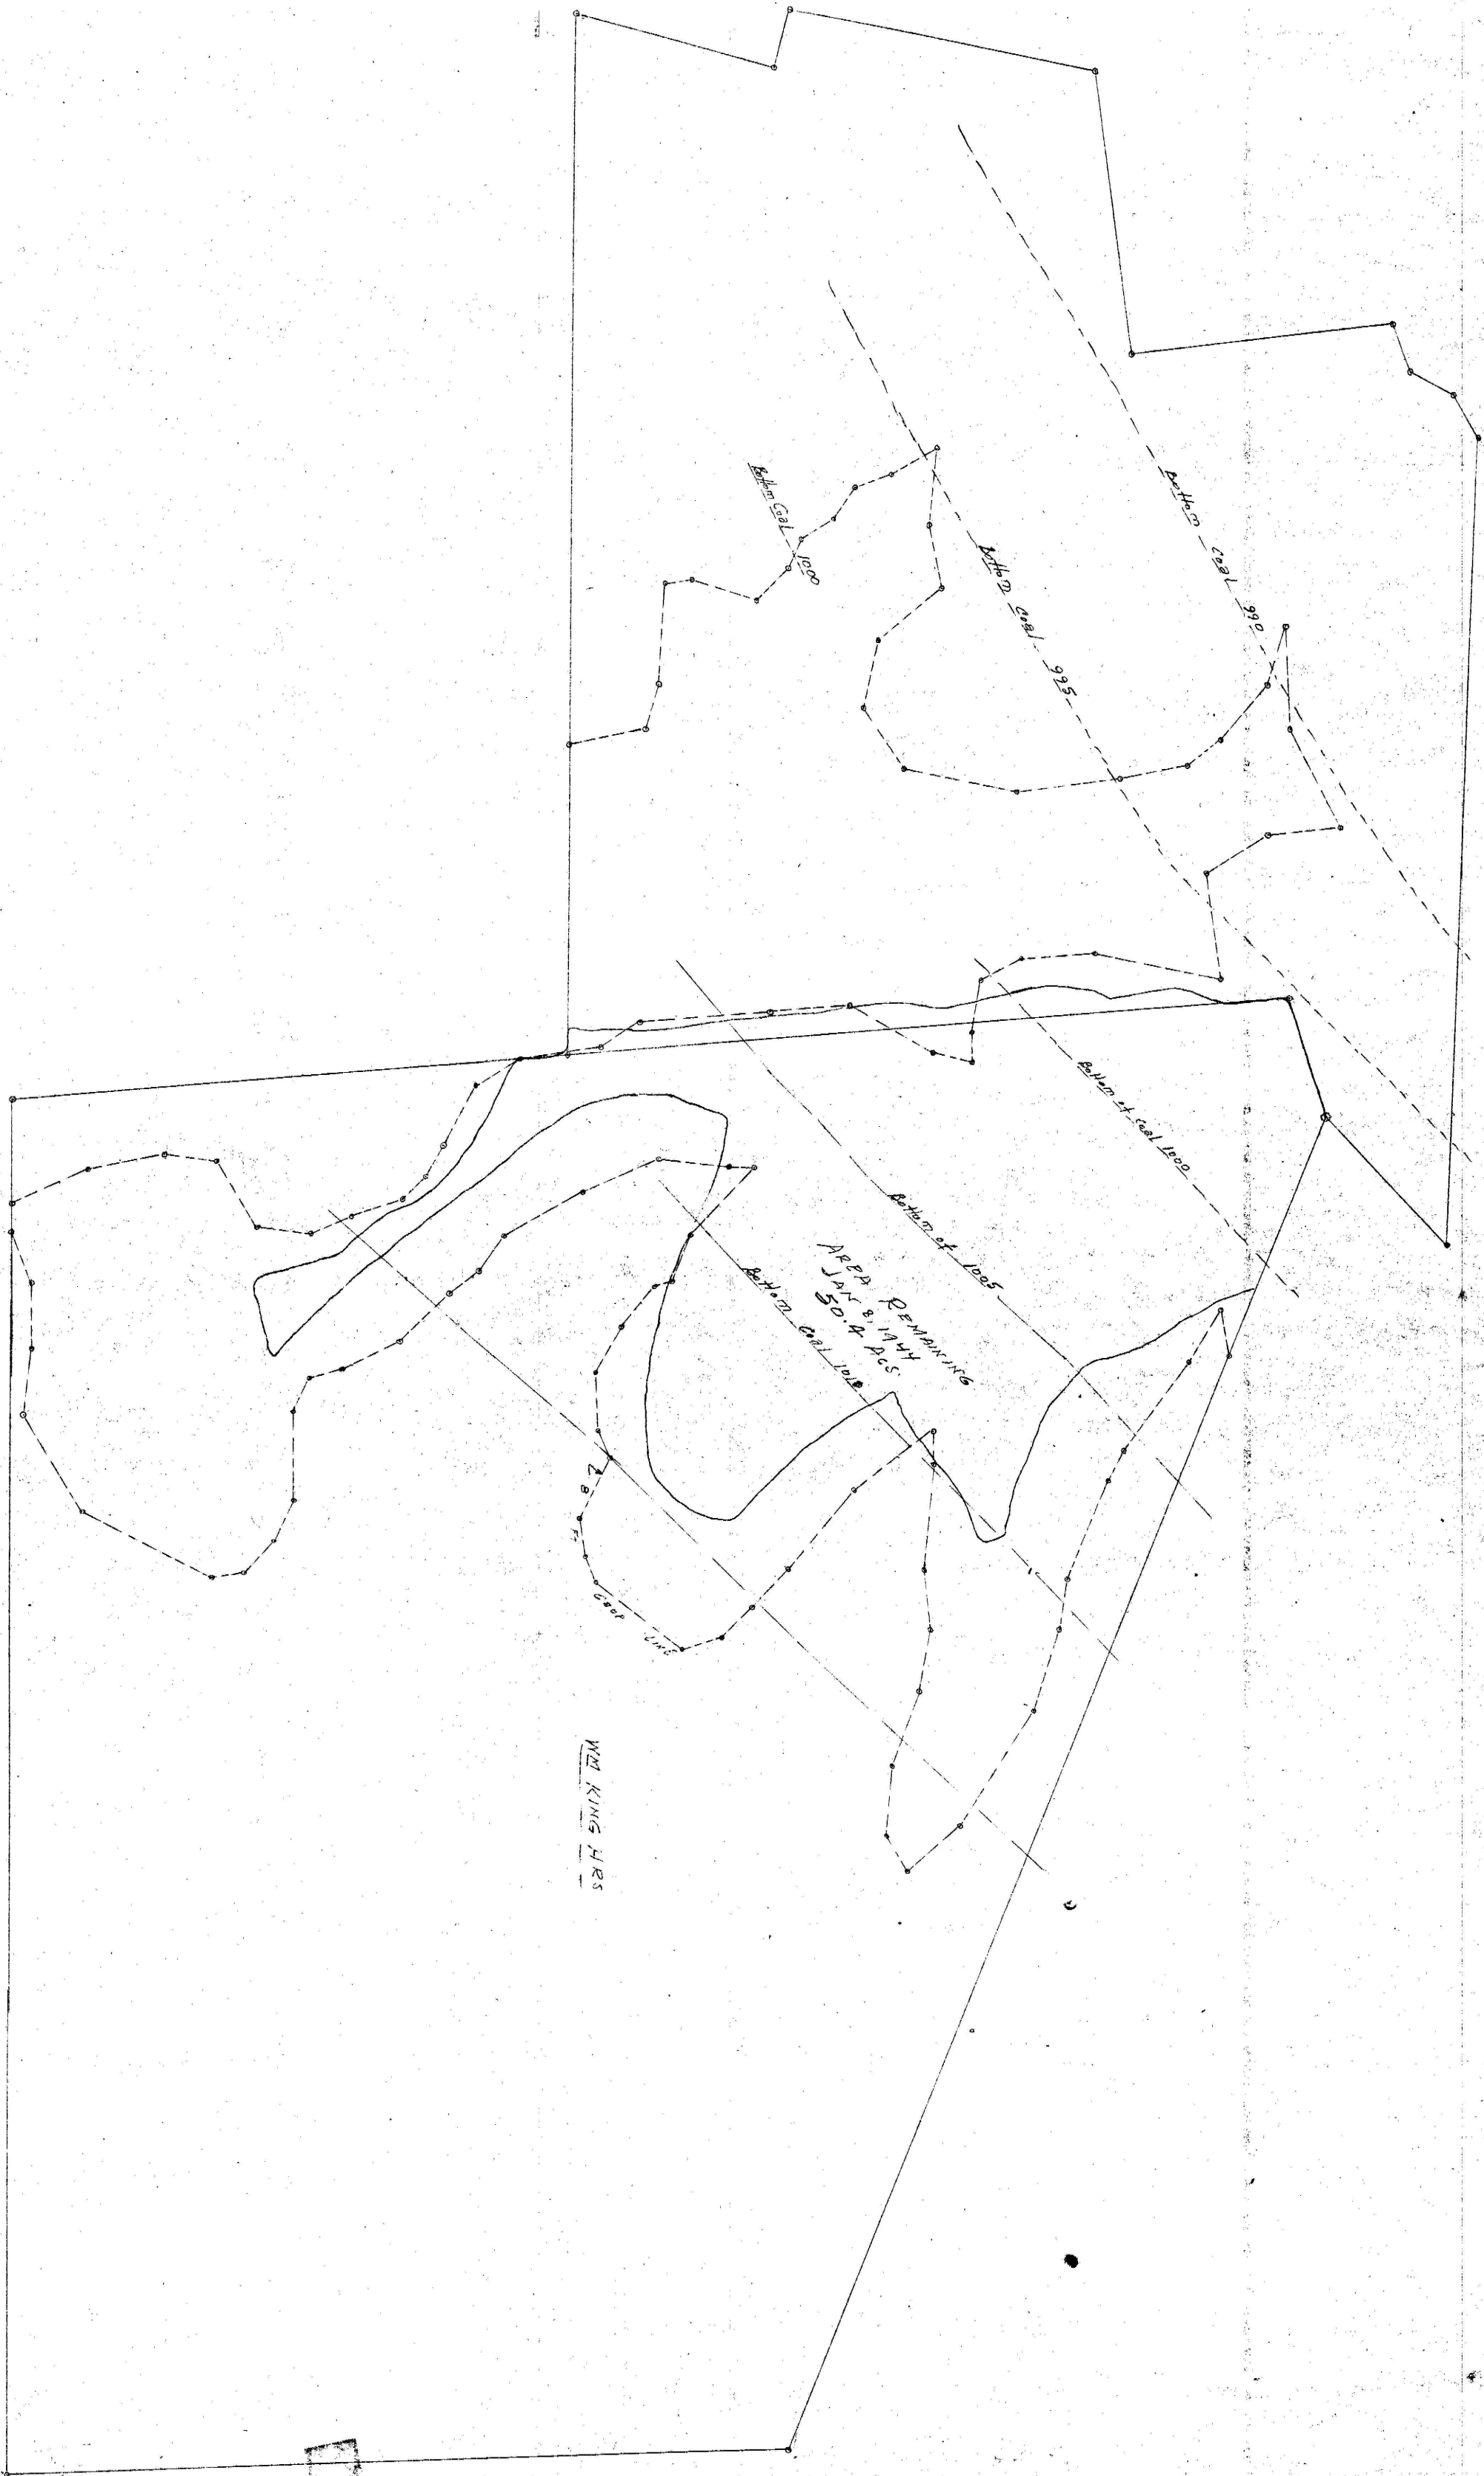

SUNNYHILL Coal Co.
KING FARM
Scale 1" = 200'
Guy A. Reed
Pittsburgh, Pa.