


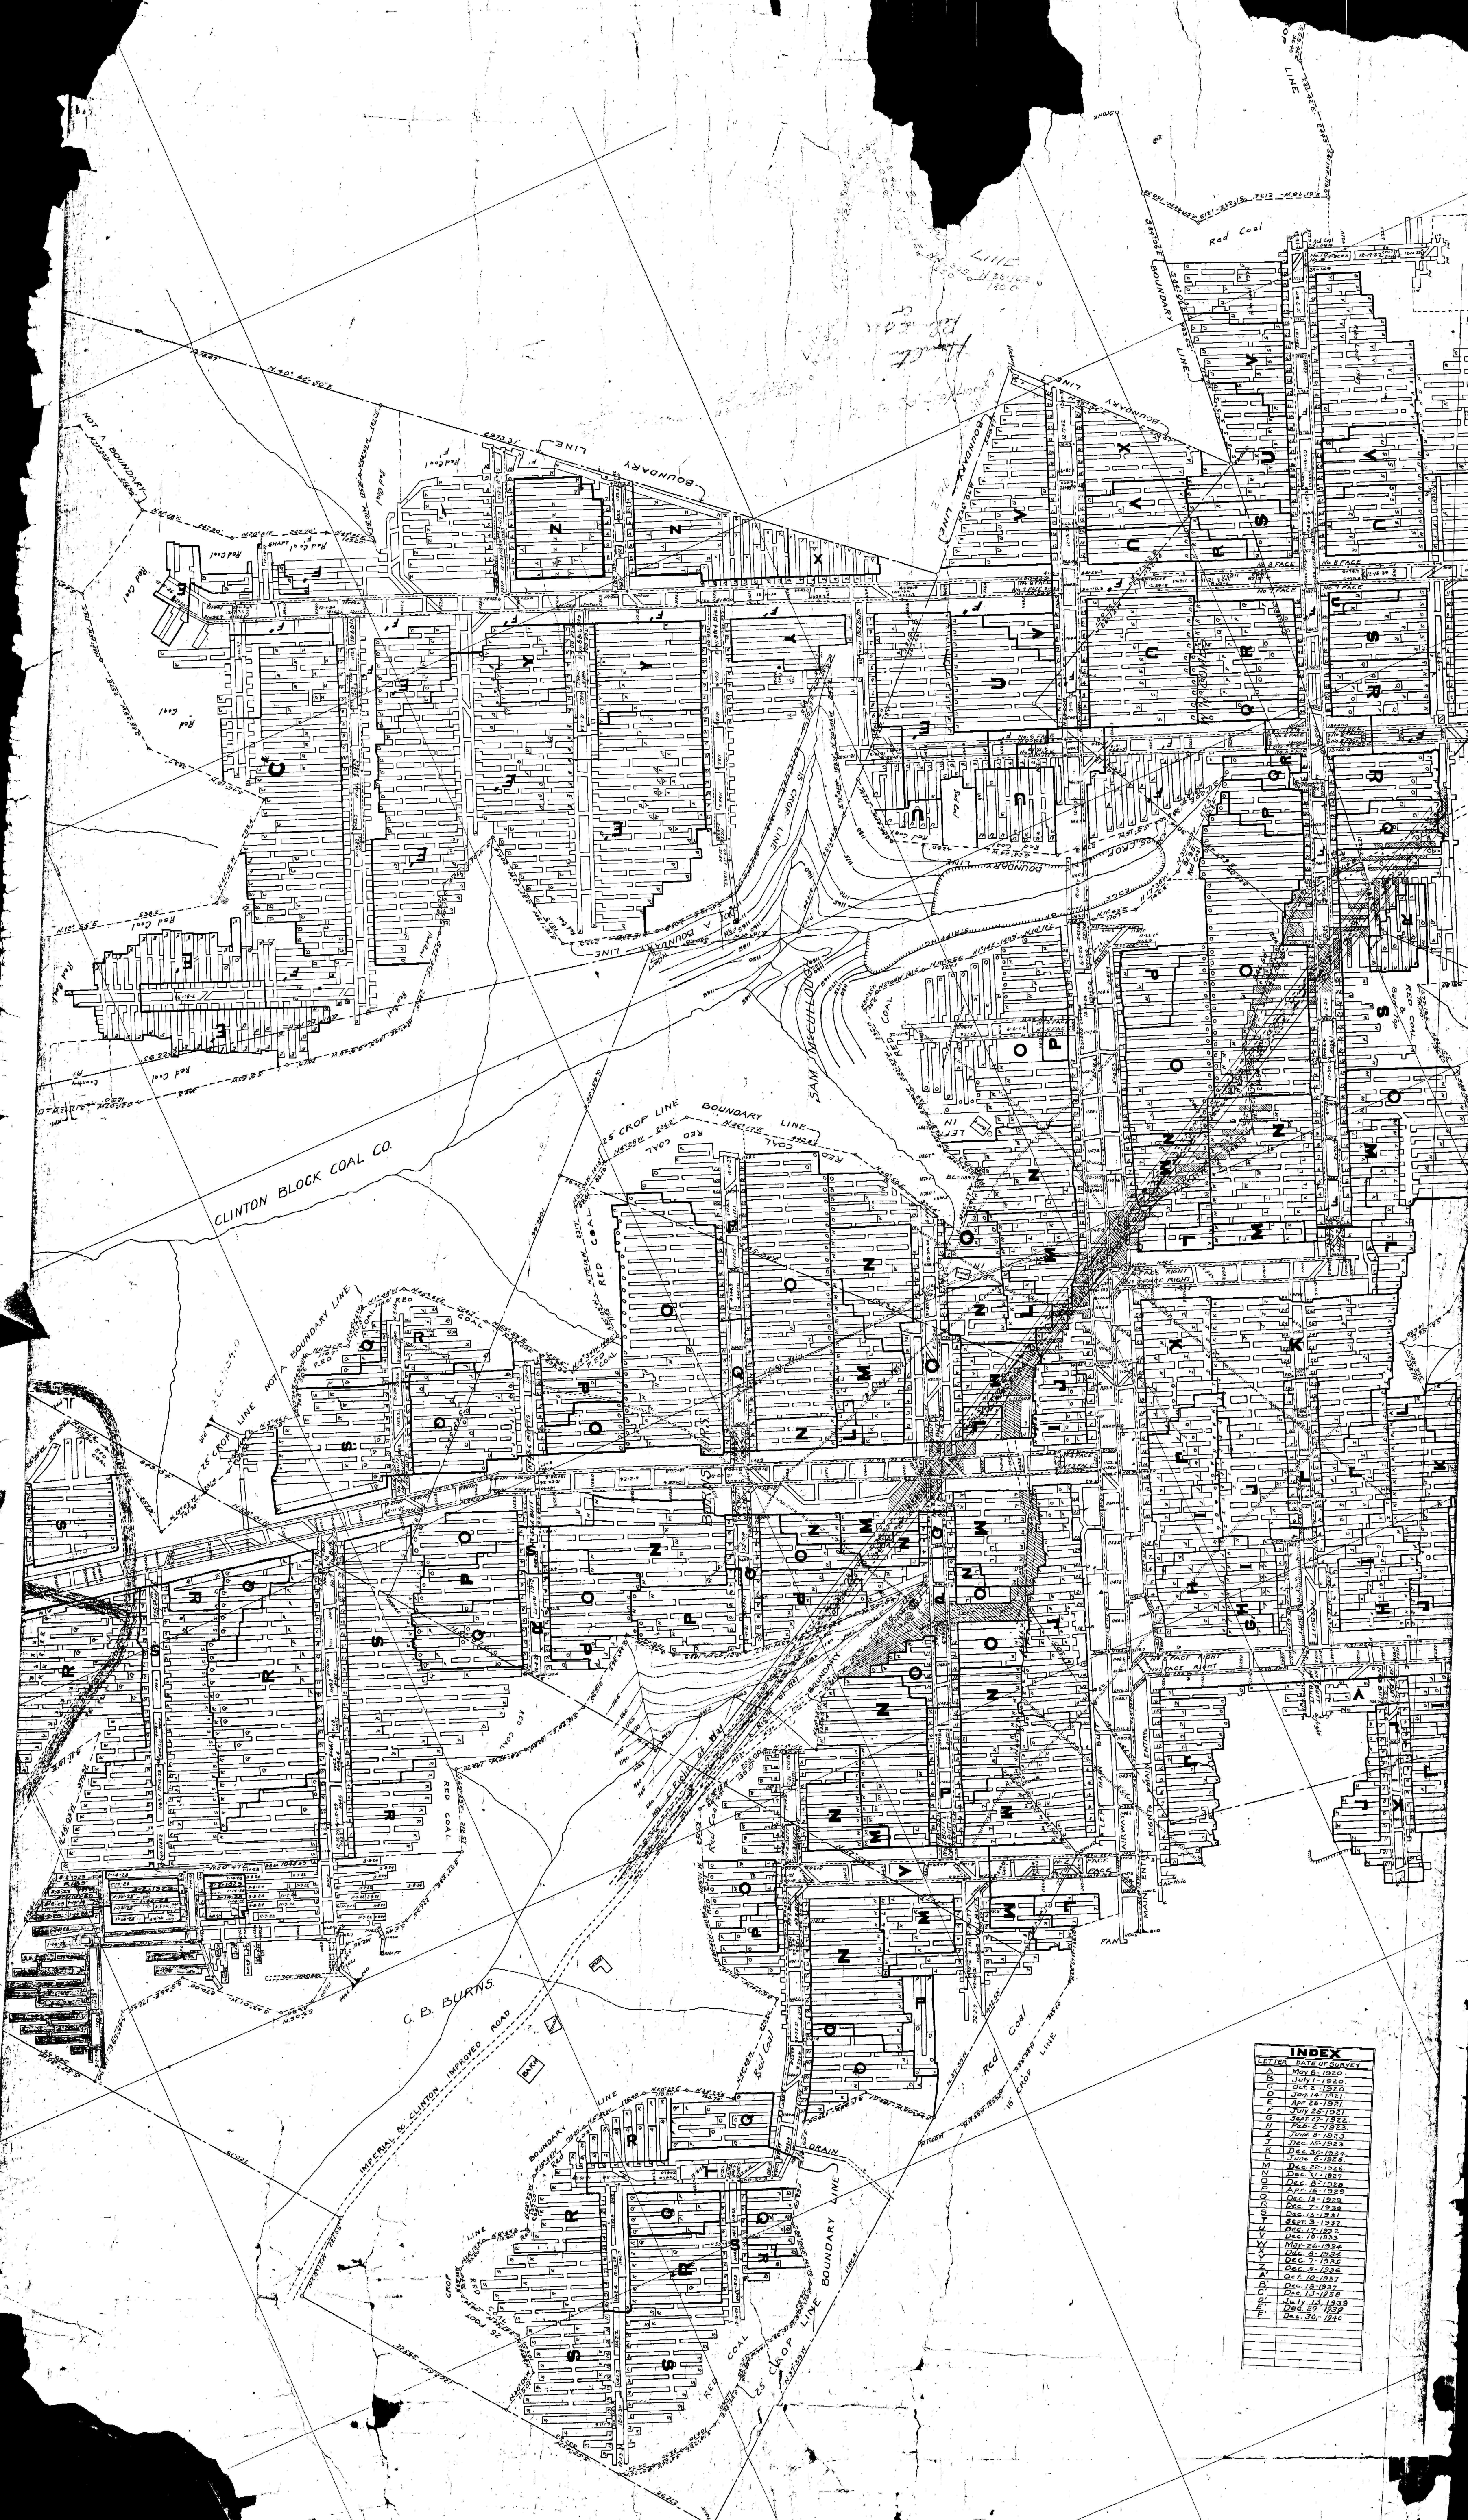

INDEX	
LETTER	DATE OF SURVEY
A	May 6, 1920
B	July 1, 1920
C	Oct 8, 1920
D	Jan 14, 1921
E	Apr 22, 1921
F	July 27, 1921
G	Sept 27, 1921
H	Dec 2, 1921
I	June 8, 1923
J	Dec 10, 1923
K	Dec 30, 1923
L	June 8, 1924
M	Dec 22, 1924
N	Dec 17, 1927
O	Dec 12, 1928
P	Dec 16, 1928
Q	Dec 18, 1928
R	Dec 7, 1929
S	Dec 13, 1931
T	Sept 3, 1932
U	Dec 17, 1932
V	Dec 16, 1933
W	May 26, 1934
X	Dec 8, 1934
Y	Dec 7, 1935
Z	Dec 8, 1936
A	Oct 10, 1937
B	Dec 15, 1938
C	Dec 13, 1938
D	July 13, 1939
E	Dec 28, 1939
F	Dec 30, 1940