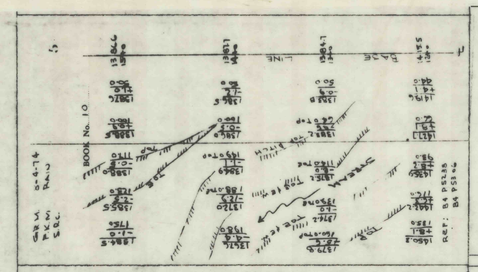

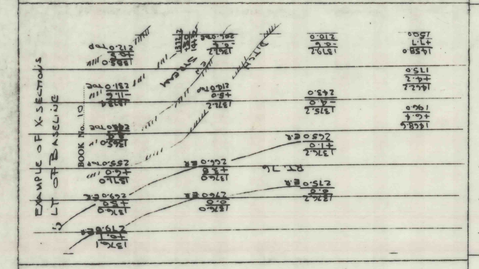

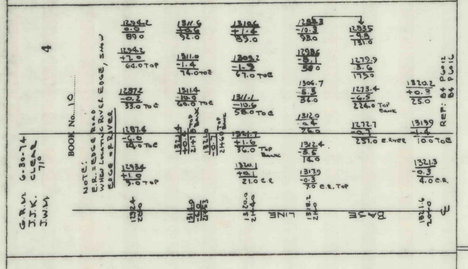

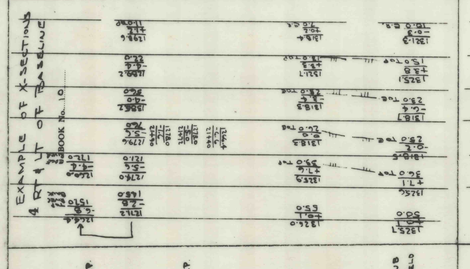

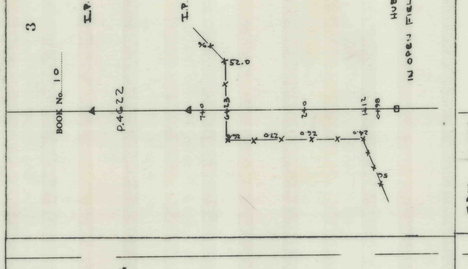

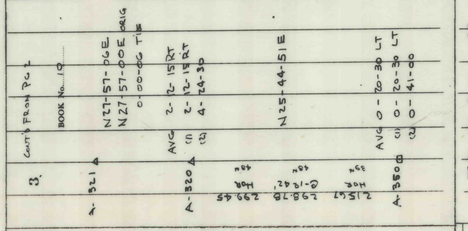

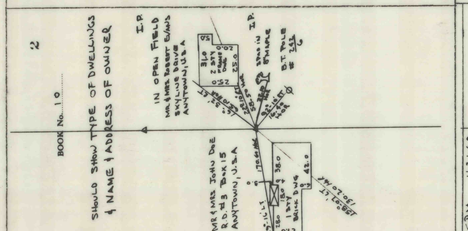

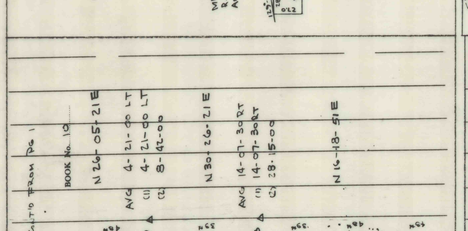

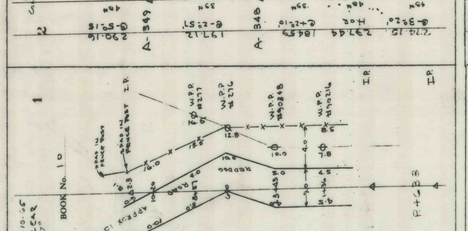

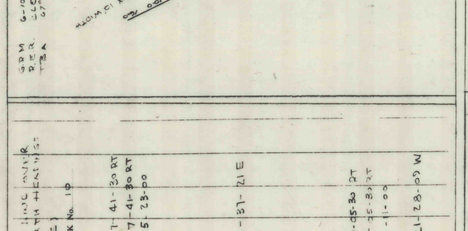

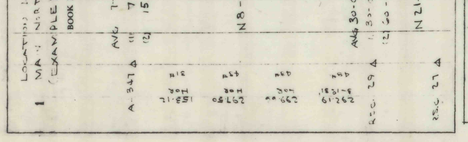

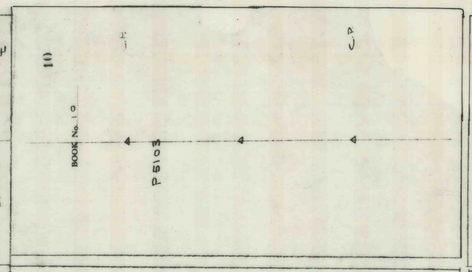

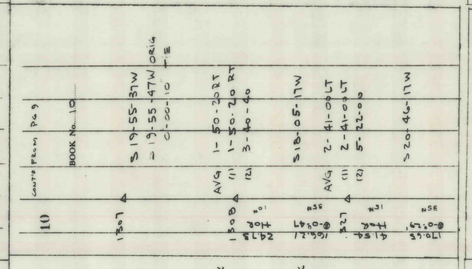

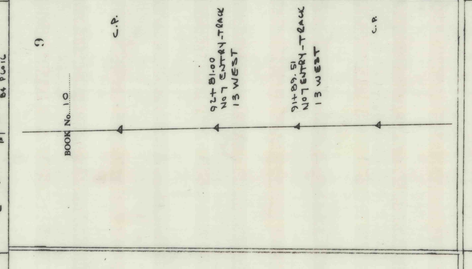

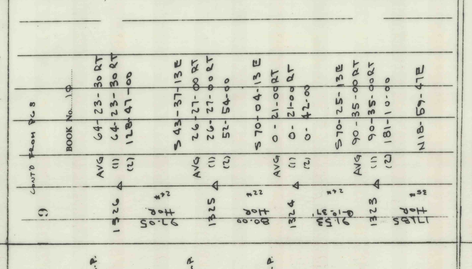

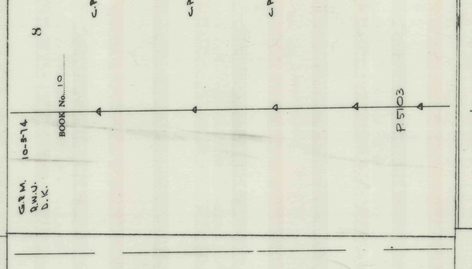

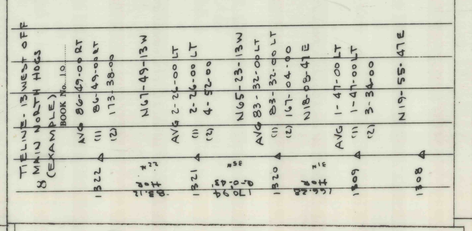

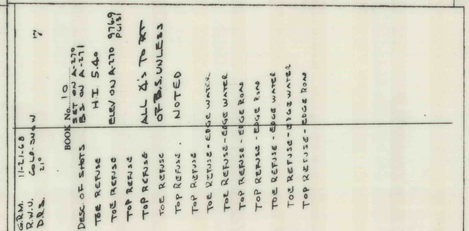

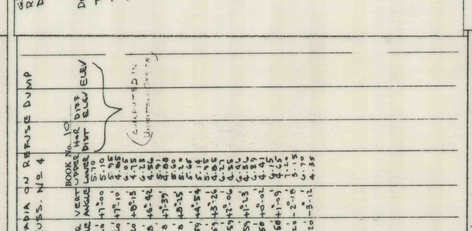

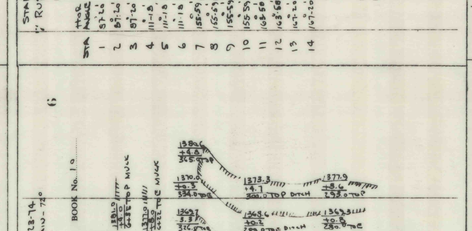

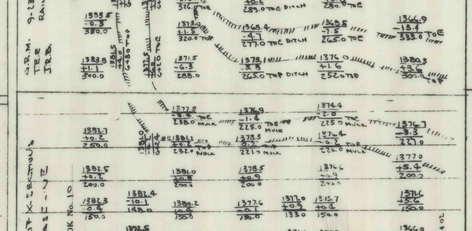

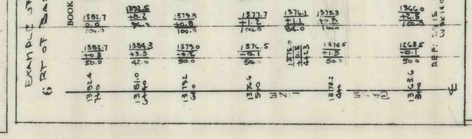

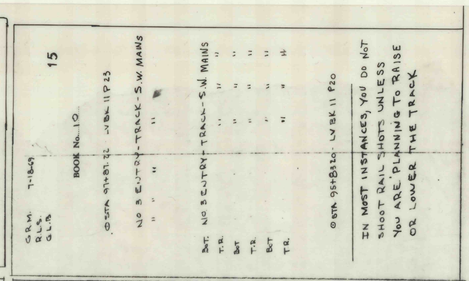

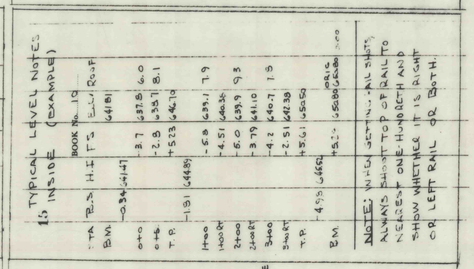

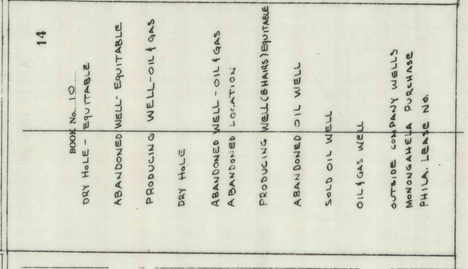

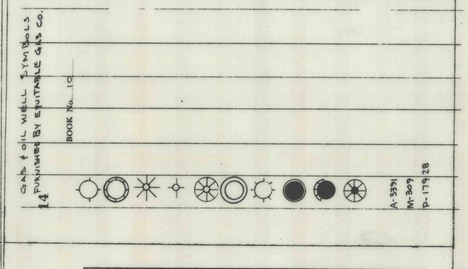

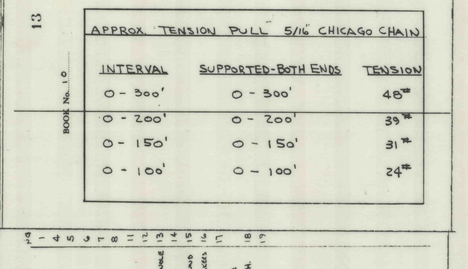
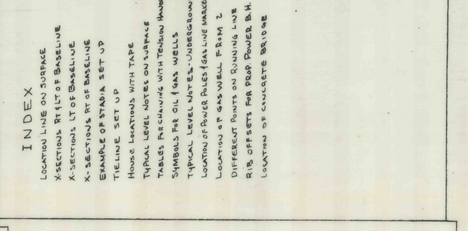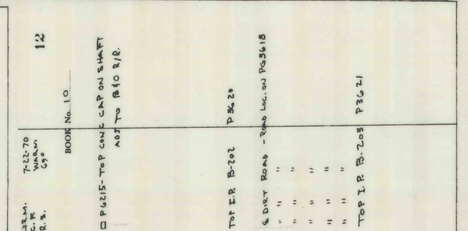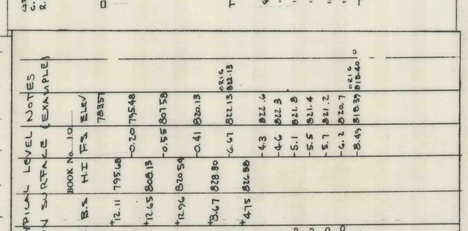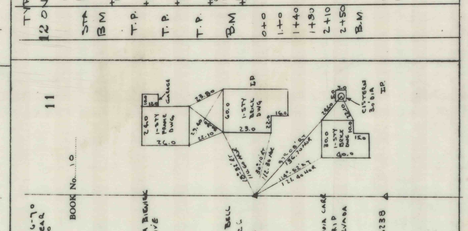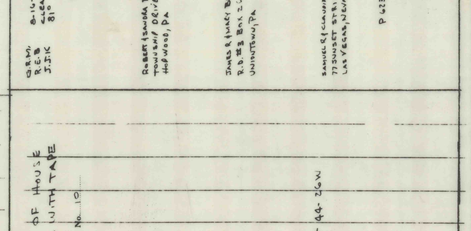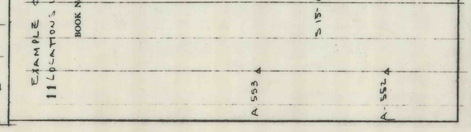 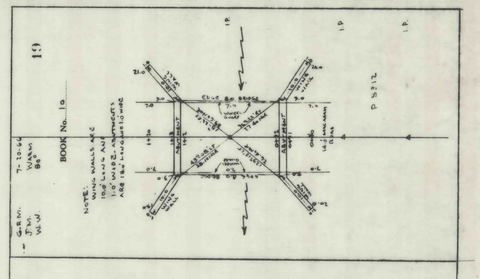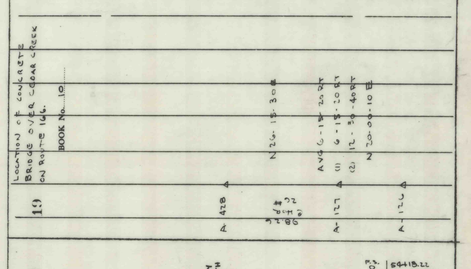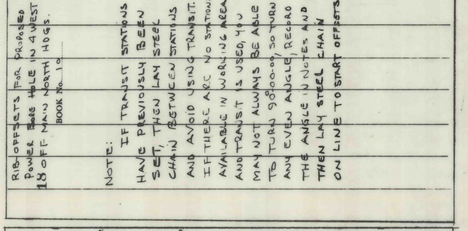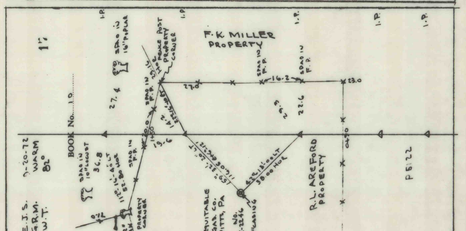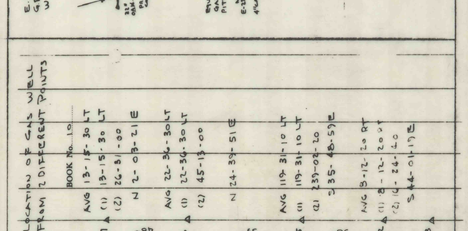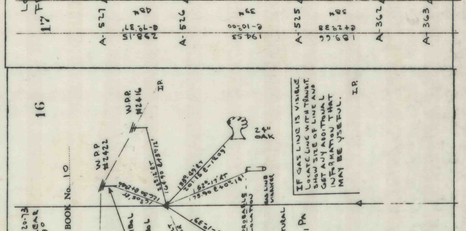
APPROX. TENSION PULL 5/16" CHICAGO CHAIN		
INTERVAL	SUPPORTED-BOTH ENDS	TENSION
0 - 300'	0 - 300'	48#
0 - 200'	0 - 200'	39#
0 - 150'	0 - 150'	31#
0 - 100'	0 - 100'	24#